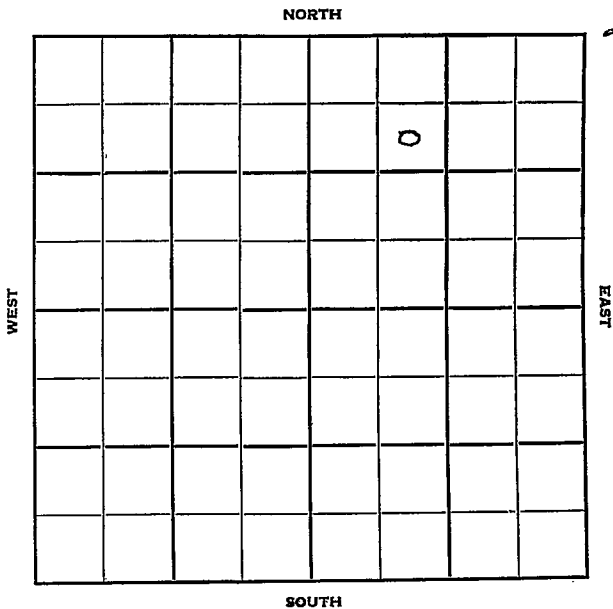


Section 25 Township 19 Range 12WWell No. #2 BrodieCompany W.L. Hartman

Barton KANSAS

Sec. 25 Twp. 19 R. 12 W

Well No. # 2 Brodie Farm

W. L. Hartman Company

Contractor

Werner-Robl


990 Ft. from N. Line

       Ft. from S. Line

       Ft. from E. Line

990 Ft. from W. Line

SE NW NE

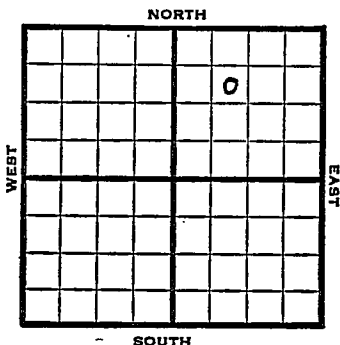

1952

Elev. 1800' REPORT

1/9  
2/6

RUR  
TD 3368'  
5" @ 3366' POP

2/13  
2/20

No report  
"

3/5

NR


3/11

"

3/19

Spud 1-8-52  
Oil Well TD 3368  
8" @ 160 Top. 2684  
DST 2878-2900 Rec. 270' hocm  
Heeb. 2940 Br Lime 3056  
Lans. 3072  
DST 3073-85 opn 1 hr. Rec. 100'  
o&gcm 20' free oil  
DST 3092-3103 opn 1 hr. Rec. 10' mud  
DST 3111-38 opn 1/2 hr.  
Rec. 120' o&gcm 240' oil  
DST 3139-51 opn 11 min. Rec. 315'  
oil DST 3158-76 opn 1 hr. Rec.  
30' mud DST 3205-17 opn 1/2 hr.  
Rec. 120' mco 300' free oil  
DST 3238-48 opn 1 hr. Rec. 30' socm  
DST 3262-70 opn 1 hr. Rec. 20' mud  
DST 3289-95 opn 1/2 hr. Rec. 15' mud  
Arb. 3365-68 5" @ 3366 GO to 3367  
FU 425' oil 12 hr. Comp. 302 bopd

COMPLETED

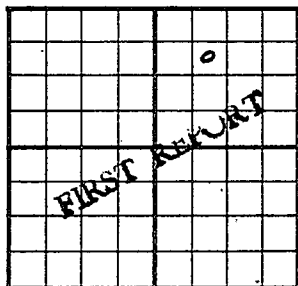County **Barton** State **Kansas**Sec. **25** (Blk.) **19** (Sur.) **12W** Map No.Operator **W. L. Hartman**Well No. **2** Farm **Brodie**Elev. Location **SE NW NE**990Ft. From **N** Line **NE**990Ft. From **W** Line Quarter1st. Report **JAN 9 1952**

Completion

Remarks

Spudding Date

**Werner - Robl**

Drlg. Data


**RUR****J. E. TYRA**

JAN 1 1 1952

|                |    |
|----------------|----|
| Scout Cards    | mm |
| Land Small Map |    |
| Land Wall Map  |    |
| Tre Cings      |    |
| France Map     |    |
| Pierce Map     |    |
| Misc.          |    |

Drig. Data

County Barton State Kansas  
 Sec. 25 (Blk.) 19 (Sur.) 12W Map No.  
 Operator W. L. Hartman  
 Well No. 2 Farm Brodie  
 Elev. 1800 Location SE NW NE

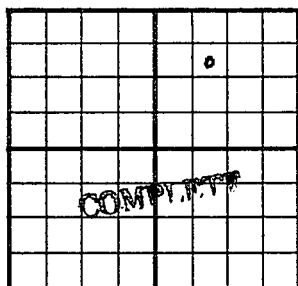

990 Ft. From N Line NE  
990 Ft. From W Line Quarter  
1st. Report  
Completion MAR 19 1952  
Remarks Werner-Robl Pool

Spudding Date 1-8-52

Drilg. Data Oil well TD 3368

8" @ 160 Top. 2684 DST 2878-2900  
Rec. 270' hoom Heeb. 2940  
Br. lime 3056 Lans. 3072 DST 3073-85  
open 1 hr. Rec. 100' o & gcm 20' free  
oil DST 3092-3103 open 1 hr. Rec.  
10' mud DST 3111-38 open  $\frac{1}{2}$  hr.  
Rec. 120' o & gcm 240' oil DST 3139-51  
open 11 min. Rec. 315' oil DST 3158-  
76 open 1 hr. Rec. 30' mud DST 3205-  
17 open  $\frac{1}{2}$  hr. Rec. 120' mco 300' free  
oil DST 3238-48 open 1 hr. Rec.  
30' socm DST 3262-70 open 1 hr.  
Rec. 20' mud DST 3289-95 open  $\frac{1}{2}$  hr.  
Rec. 15' mud Arb. 3365-68 5" @ 3366

J. G. McGEHEE

Drig. Data

GO to 3367 FU 425' oil 12 hr.

Comp. 302 bopd

Scout Cards .....

Land Small Map .....

Land Wall Map .....

Tracings .....

France Map .....

Pierce Map .....

Misc. ....

25 1992