


Barton

Section 25 Township 19 Range 12W **KANSAS**

Well No. #4 Brodie

Company W. L. Hartman

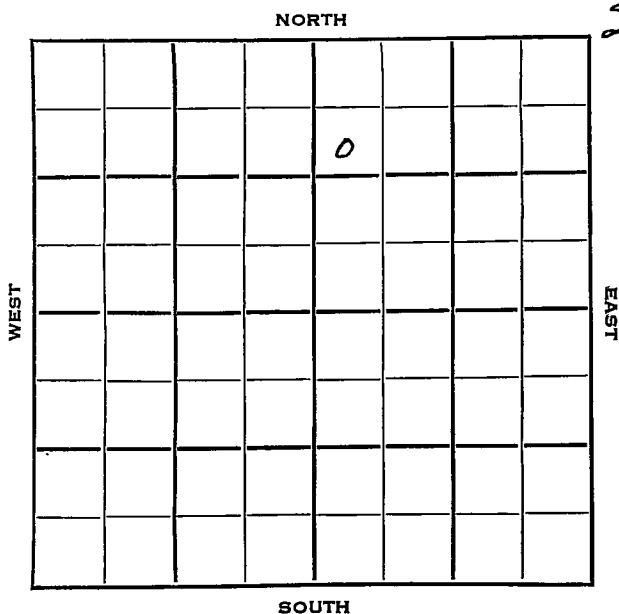

Sec. 25 Twp. 19 R. 12WWell No. #1 Brodie FarmW. L. Hartman Company

Contractor


990 Ft. from N. Line

Ft. from S. Line

Ft. from E. Line

330 Ft. from W. Line

SW NW NE

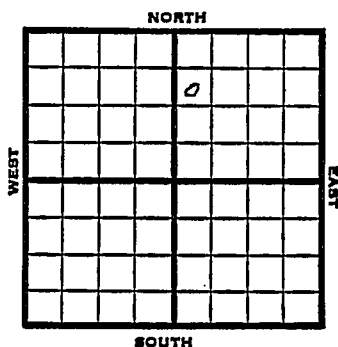

1953 Elev 1800' REPORT

3/4 Spudded 2/26/53
8" @ 178 Drlg. 17753/12 Top 2678' Heeb 2940' Br li 3057
Lans. 3075
Drlg. 31363/19 BKC 3325, Arb 3338,
RTD 3340
5" @ 3339'

3/26 CO 3340' SO 1000 A

4/2 POP

4/9 "

4/16 NR

4/23 NR

4/29 Spud 2-26-53

Oil Well

TD 3340'

8" @ 178'

Top. 2678, Heeb 2940, Br. Lime 3057,
Lans 3075, B KC 3325, Arb 3338

TD 3340'

5" @ 3339'

CO to 3340

1000 A

Comp. 25 bopd.

COMPLETED

County Barton State Kansas
 Sec. 25 (Blk. 19) (Sur. 12W) Map No. 12W
 Operator W. L. Hartman
 Well No. 4 Farm Brodie
 Elev. _____ Location SW NW NE

		9			

FIRST REPORT


990 Ft. From N Line NE
 330 Ft. From W Line Quarter
 1st. Report MAR 4 1953
 Completion _____
 Remarks _____
 Spudding Date 2-26-53

Drlg. Data

8" @ 178 drlg. 1775

J. G. McGEHEE

County Barton State Kansas
 Sec. 25 (Blk.) 19 (Sur.) 12W Map No.
 Operator W. L. Hartman
 Well No. 4 Farm Brodie
 Elev. 1800 Location SW NW NE

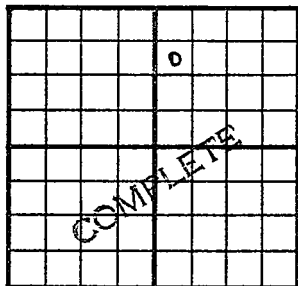

990 Ft. From N Line NE
330 Ft. From W Line Quarter
1st. Report
Completion APR 29 1953
Remarks

Spudding Date 2-26-53

Drig. Data Oil well TD 3340
8" @ 178 Top. 2678 Heeb. 2940
Br. lime 3057 Lans. 3075 B KC 3325
Arb. 3338 TD 3340 5" @ 3339 CO to 3340
1000 A Comp. 25 bopd