



KANSAS

Rice

Sec. 25 Twp. 19 R. 10-W

Well No. 1 Finger Farm

Harwood et al Company


Silica Pool

\_\_\_\_\_ Ft. from N. Line

990 Ft. from S. Line

\_\_\_\_\_ Ft. from E. Line

330 Ft. from W. Line

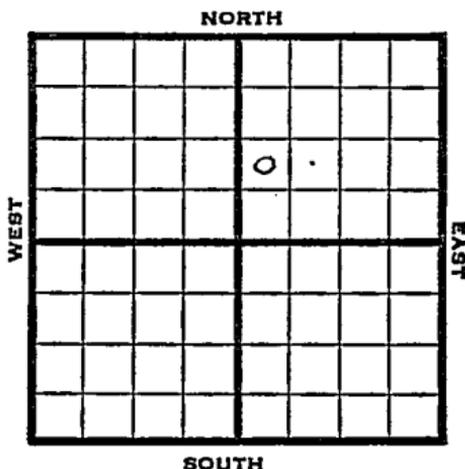

NW SW NE

1947	Elev. 1738' REPORT
9/3	Loc.
9/10	8-5/8" @ 236' Anhydrite 665' Drlg. 1620'
9/17	Lansing 2955' Arbuckle 3286' TD 3293' Run 5"
9/24	SLM 3293-90' Arbuckle 3283' 5" @ 3284' TD 3293' sso
10/1	500 acid.
10/8	Swb 2 bbls water & 3/4 bbls oil PH, 24 hrs.
10/15	"
10/22	Arbuckle 3283' 5" @ 3284' 500 Acid Total Depth 3293'
	<b>ABANDONED</b>

Map No. \_\_\_\_\_ Sec. 25 Twp. 19 R. 10W

Well No. 1 Finger

Harwood et al. Company

FIRST REPORT

Contractor

NW SW NE

SECTION PLAT

\_\_\_\_\_ Ft. from N. Line

990 Ft. from S. Line

\_\_\_\_\_ Ft. from E. Line

330 Ft. from W. Line


Rice County

Location X

Rig up

Drilling and Remarks:

RECORD

Cased \_\_\_\_\_ in., \_\_\_\_\_ ft.

Sand \_\_\_\_\_

Gas \_\_\_\_\_

Oil \_\_\_\_\_

Total Depth \_\_\_\_\_

PRODUCTION

1st 24 hrs. Nat. \_\_\_\_\_

1st 24 hrs. after shot \_\_\_\_\_

Gas \_\_\_\_\_ Cu. Ft.

Dry Hole \_\_\_\_\_

Abandoned \_\_\_\_\_

Date

SEP 3 1947 19

S. J. LEWIS

Scout

