

KANSAS


FORM 51 5M 10-41 PETROL

Rice

Section 25 Township 19 Range 10-W

Well No. #2 Proffitt

Company Harwood Oil

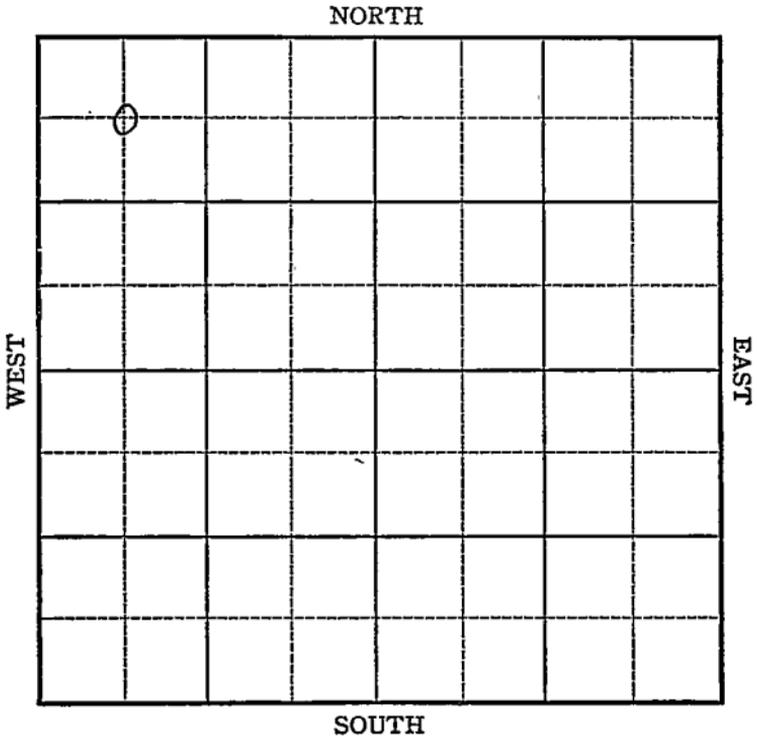

Sec. 25 Twp. 19 R. 10-W

Well No. #2 Proffitt Farm

Harwood Oil Company


Chase

660 Ft. from N. Line

_____ Ft. from S. Line

_____ Ft. from E. Line

660 Ft. from W. Line

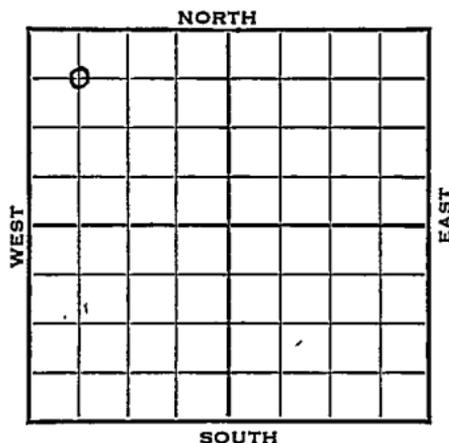

C NW NW Elev. 1741

1943

REPORT

- 1/20 Rotary
- 1/27 10" Casing set 218'
Drlg. 1650'
- 2/3 Drlg. 2920'
- 2/10 Lans 2951
Arb. 3305
T.D. 3317'
No shows

ABANDONED

Rice

KANSAS 16 Sec. 25 Twp. 19 R. 10W

Well No. 2 Proffitt

Harwood Oil Company

Contractor

C NW NW

SECTION PLAT

660 Ft. from N. Line

_____ Ft. from S. Line

_____ Ft. from E. Line

660 Ft. from W. Line

o			

CHASE POOL

Location _____

Rig up _____

Drilling and Remarks:

Rotary

RECORD

Cased _____ in., _____ ft.

Sand _____

Gas _____

Oil _____

Total Depth _____

PRODUCTION

1st 24 hrs. Nat. _____

1st 24 hrs. after shot _____

Gas _____ Cu. Ft.

Dry Hole _____

Abandoned _____

Date

JAN 20 1943 19

S. J. LEWIS Scout

Map No. 76 Sec. 25 Twp. 19 R. 10WWell No. 2 ProffittHarwood Oil Company

ABANDONED

Contractor

C NW NW

SECTION PLAT

660 Ft. from N. Line

_____ Ft. from S. Line

_____ Ft. from E. Line

660 Ft. from W. Line

o			

CHASE POOL

Location _____

Rig up _____

Drilling and Remarks:

*Lans 2957**Per 3305**No shows*

RECORD

Cased _____ in., _____ ft.

Sand _____

Gas _____

Oil _____

Total Depth 3317

PRODUCTION

1st 24 hrs. Nat. _____

1st 24 hrs. after shot _____

Gas _____ Cu. Ft.

Dry Hole _____

Abandoned _____

Date

FEB 10 1943 19

S. J. LEWIS Scout