


Rice

Form 51-5M-11-38-Palace

Section 25 Township 19 Range 10-WWell No. 1 Wm. HandyCompany Gulf

NORTH Barngrover Pool

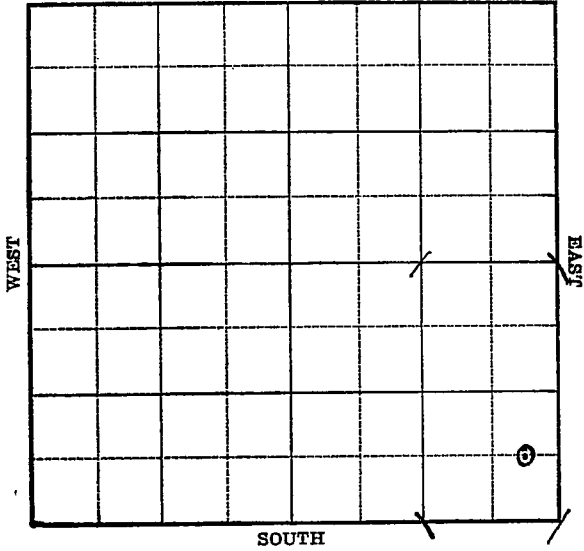

Rice

KANSAS

Map No. 46 Sec. 25 Twp. 19 R. 10WWell No. 1 Wm. Handy

Gulf


Company

Contractor

FIRST REPORT

C E L S E S E

SECTION PLAT

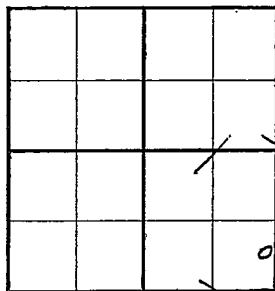

_____ Ft. from N. Line

660 Ft. from S. Line330 Ft. from E. Line

_____ Ft. from W. Line

BARNGROVER POOL

Location _____

Rig up _____

Drilling and Remarks:

RUR

RECORD

Cased _____ in., _____ ft.

Sand _____

Gas _____

Oil _____

Total Depth _____

PRODUCTION

1st 24 hrs. Nat. _____

1st 24 hrs. after shot _____

Gas _____ Cu. Ft.

Dry Hole _____

Abandoned _____

Date

APR 26 1939

19

H. D. Hatfield Scout

Rice

KANSAS

Map No.

46

Sec.

25

Twp.

19

R.

10W

Well No. 1 Wm. Handy

Gulf

Company

Contractor

COMPLETED

C E L S E S E


Ft. from N. Line

660 Ft. from S. Line

330 Ft. from E. Line

Ft. from W. Line

SECTION PLAT

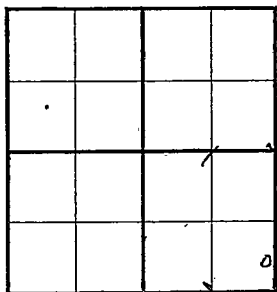

BARNGROVER POOL

Location

Rig up

Drilling and Remarks:

Or 3283

8" @ 3283

2000 aad

P 453 pump.

RECORD

Cased in., ft.

Sand

Gas

Oil

Total Depth 3290

PRODUCTION

1st 24 hrs. Nat.

1st 24 hrs. after shot

Gas Cu. Ft.

Dry Hole

Abandoned

Date

MAY 31 1939

19

S. J. LEWIS

Scout