


Section 25 Township 19S Range LOW

Well No. #1 Heinē

Company G.W. Keyes

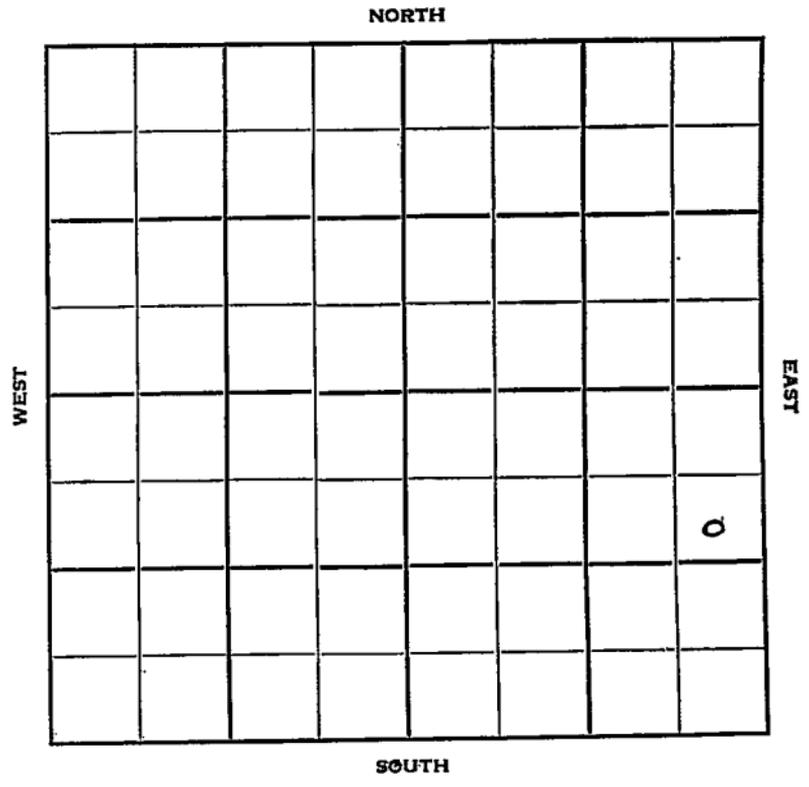


Rice

~~KANSAS~~

Sec. 25 Twp. 19 R. 10W

Well No. #1 Heine Farm _____
G. W. Keyes Company _____
Contractor _____

990' Ft. from N. Line
_____ Ft. from S. Line
330' Ft. from E. Line
_____ Ft. from W. Line

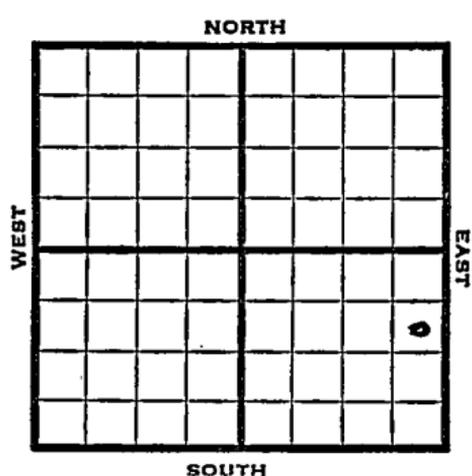

SE NE SE

1951

Elev. 1736' REPORT

12/19

Spud 12-9-51
8" @ 150 -
Heeb. 2806
Br. L 2932
Lans. 2952
BKC 3221
Cong. 3270
Arb. 3281
TD 3302
D&A

~~FIRST REPORT~~
ABANDONED

