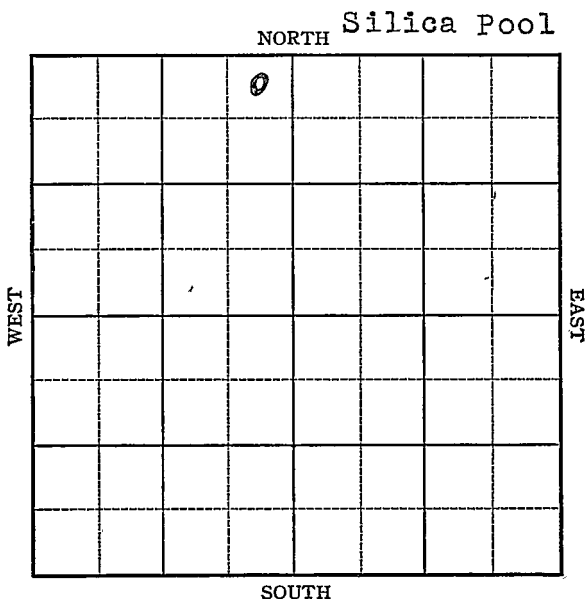


KANSAS


FORM 51 5M 4-41 PETROL

Rice

Section 25 Township 19 Range 10-WWell No. #1 ProffittCompany Harwood Oil
Austin

Sec. 25 Twp. 19 R. 10-WWell No. #1 Proffitt FarmAustin Harwood Oil Company
(Silica)330 Ft. from N. Line Ft. from S. Line330 Ft. from E. Line Ft. from W. Line

Elev. 1738

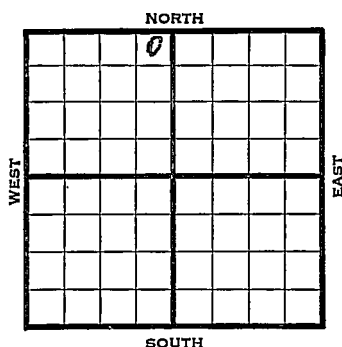

1942	REPORT
6/10	Location
6/17	"
6/24	"
7/1	"
7/8	"
7/15	"
7/22	"
7/29	"
8/5	"
8/12	8" @ 208 Drlg 1575
8/19	Drlg. 2880'
8/27	"
9/2	Arb. 3280 5" - 3281 T.D. 3290 5000 acid - testing.
9/9	2000 Acid HFO
9/16	Pump 10 oil per hr
9/23	Arb. 3280' 5" 3281 TD 3290 2000 acid Depth Pot 567 oil plus 67 water 44.2 Gr.
	COMPLETED

KANSAS

Rice

Map No. 46 Sec. 25 Twp. 19 R. 10WWell No. 1 Proffitt

Austin

Company

FIRST REPORT

Contractor

NE NW

SECTION PLAT

330 Ft. from N. Line

Ft. from S. Line

330 Ft. from E. Line

Ft. from W. Line

SILICA POOL

Location XXX

Rig up

Drilling and Remarks:

RECORD

Cased _____ in., _____ ft.

Sand _____

Gas _____

Oil _____

Total Depth _____

PRODUCTION

1st 24 hrs. Nat. _____

1st 24 hrs. after shot _____

Gas _____ Cu. Ft.

Dry Hole _____

Abandoned _____

Date

JUN 10 1942 19S. L. LEWIS

Scout

Rice

KANSAS

Map No. 46 Sec. 25 Twp. 19 R. 10WWell No. 1 Proffitt

Harwood Oil _____ Company

CORRECTION_____
Contractor

NE NW

SECTION PLAT

330 Ft. from N. Line_____
Ft. from S. Line330 Ft. from E. Line_____
Ft. from W. Line

	0		

SILICA POOL

Location _____

Rig up _____

Drilling and Remarks: _____

Reported _____

Austin _____

RECORD

Cased _____ in., _____ ft.

Sand _____

Gas _____

Oil _____

Total Depth _____

PRODUCTION

1st 24 hrs. Nat. _____

1st 24 hrs. after shot _____

Gas _____ Cu. Ft.

Dry Hole _____

Abandoned _____

Date

JUL 1 1942 19 _____ S. J. LEWIS Scout

KANSAS

Rice

Map No. 46 Sec. 25 Twp. 19 R. 10WWell No. 1 Proffitt

Harwood Oil

Company

COMPLETED

Contractor

NE NW

SECTION PLAT

330 Ft. from N. Line

Ft. from S. Line

330 Ft. from E. Line

Ft. from W. Line

SILICA POOL

RECORD

Location Cased in., ft.Rig up Sand Drilling and Remarks: Gas Oil Total Depth 3290

PRODUCTION

1st 24 hrs. Nat. 1st 24 hrs. after shot Gas Cu. Ft.Dry Hole Abandoned

Date

SEP 23 1942 19

S. J. LEWIS Scout

Ar 83280
 5" @ 3281
 2000 acid
 Sept 20 8 567.00
 467 Water
 44 2 Gr