

Section 25 Township 19 Range 10-W


Well No. 3 Proffitt

Harwood oil et al.

Company B & R Drilg.

Silica Pool

NORTH

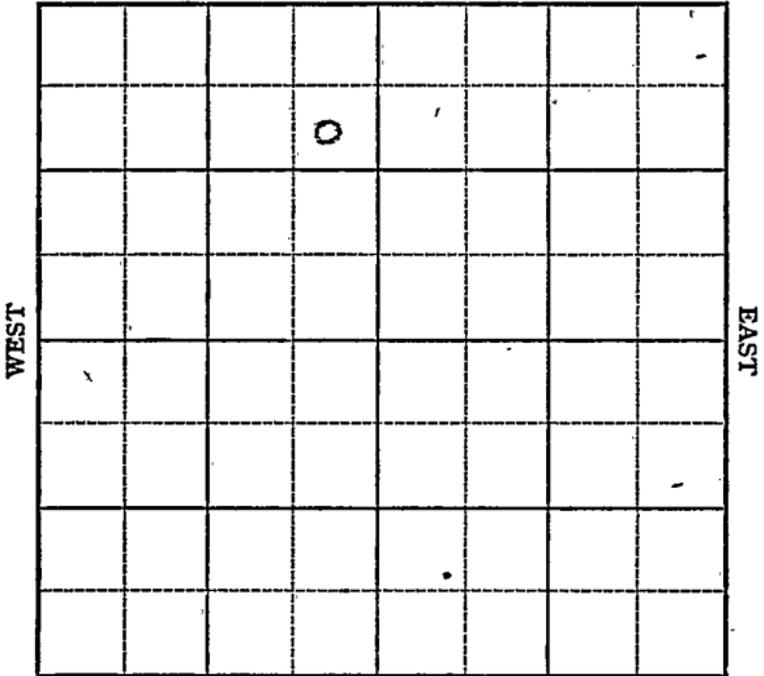


SOUTH

Sec. 25 **KANSAS** Twp. 19 R. 10W

Well No. 3 Proffitt Farm
Harwood Oil et al
B & R Drig. Company

Silica Pool
990 Ft. from N. Line
 Ft. from S. Line
330 Ft. from E. Line
 Ft. from W. Line

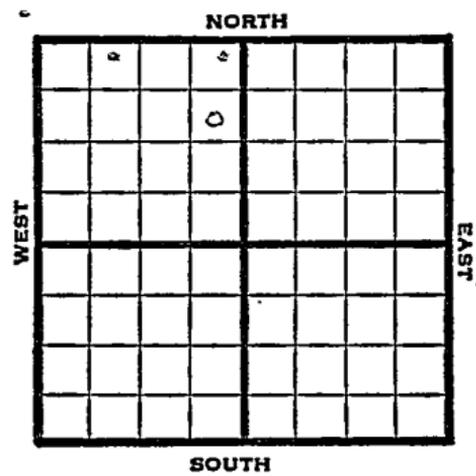

SE NE NW

1947		Elev. 1739'	REPORT
7-16	8-5/8 @ 200 anhy 440 Drig. 1430		
7/22	T.D. 1778' Fishing		
7/29	Skid rig 23' North 8" @ 245' Drig. 1640'		
8/6	Lansing 2936' Arbuckle 3272' TD 3275' 5" @ 3273' RUST		
8/13	"		
8/20	800' oil 1 hr.		
8/27	Pump 10 bb'ls. oil PH, 4 hrs.		
9/3	"		
9/10	"		
9/17	"		

OVER

1947

9/24

Arb. 3272'

5" @ 3273'

500 acid

Pump 60 pot.

42.4 Gr.

TD 3275'

COMPLETED

Map No. _____ Sec. 25 Twp. 19 R. 10W

Well No. 3 Proffitt

B & R Drlg.

Company

FIRST REPORT

Contractor

SE NE NW

SECTION PLAT

990 Ft. from N. Line

_____ Ft. from S. Line

330 Ft. from E. Line

_____ Ft. from W. Line

	o		

Rice County

Location _____

Rig up _____

Drilling and Remarks:

8 5/8 @ 200
anhy 440
drlg. 1430

RECORD

Cased _____ in, _____ ft.

Sand _____

Gas _____

Oil _____

Total Depth _____

PRODUCTION

1st 24 hrs. Nat. _____

1st 24 hrs. after shot _____

Gas _____ Cu. Ft.

Dry Hole _____

Abandoned _____

Date

JUL 16 1947 19

S. J. LEWIS Scout

Misc Small Maps

Cards

Tracing

France Map

Scarborough Map

Pierce Map

Geological Dept

Pierce Plat Book

Map No. 46 Sec. 25 Twp. 19 R. 10W

Well No. 3 Proffitt

Harwood Oil etal. Company

CORRECTION

Contractor

SE NE NW


SECTION PLAT

990 Ft. from N. Line

_____ Ft. from S. Line

330 Ft. from E. Line

_____ Ft. from W. Line

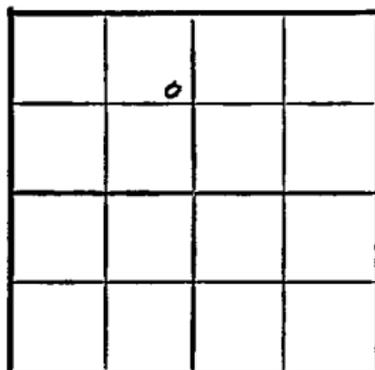

Rice County

Location _____

Rig up _____

Drilling and Remarks:

Reported

B & R Drlg.

RECORD

Cased _____ in., _____ ft.

Sand _____

Gas _____

Oil _____

Total Depth _____

PRODUCTION

1st 24 hrs. Nat. _____

1st 24 hrs. after shot _____

Gas _____ Cu. Ft.

Dry Hole _____

Abandoned _____

Date

AUG 20 1947

19

S. J. LEWIS

Scout

Wm. Map

Misc. Small f *cc*

Cards *cc*

Tracing *cc*

France Map *cc*

Scarborough Map *cc*

Pierce Map *cc*

Geological Dept. _____

Pierce Map Book _____

Map No. 46 Sec. 25 Twp. 19 R. 10W

Well No. 3 Proffitt

Harwood Oil etal. Company

COMPLETE

Contractor

SE NE NW

E 11789
SECTION PLAT

990 Ft. from N. Line

_____ Ft. from S. Line

330 Ft. from E. Line

_____ Ft. from W. Line

	o		

Rice County

Location _____

Rig up _____

Drilling and Remarks:

Cor 3272
5" @ 3272
500 acid
Pump 60 ft
42 1/2 ft

RECORD

Cased _____ in., _____ ft.

Sand _____

Gas _____

Oil _____

Total Depth 3275

PRODUCTION

1st 24 hrs. Nat. _____

1st 24 hrs. after shot _____

Gas _____ Cu. Ft.

Dry Hole _____

Abandoned _____

Date

SEP 24 1947 19

S. J. LEWIS Scout

Wm

Misc. Small Maps	<i>E</i>
Cards	<i>Luth</i>
Tracing	<i>J. J.</i>
France Map	<i>J. J.</i>
Scarborough Maps	<i>J. J.</i>
Pierce Map	<i>J.</i>
Geological Dept.	
Pierce Plat Book	