

O.W.W.O.

Rice

FORM 51 IOM 12-46 PETROL

KANSAS

Section 25 Township 19 Range 10-W

Well No. #4 Proffitt


Company Harwood Oil etal

Silica

NORTH

WEST

EAST

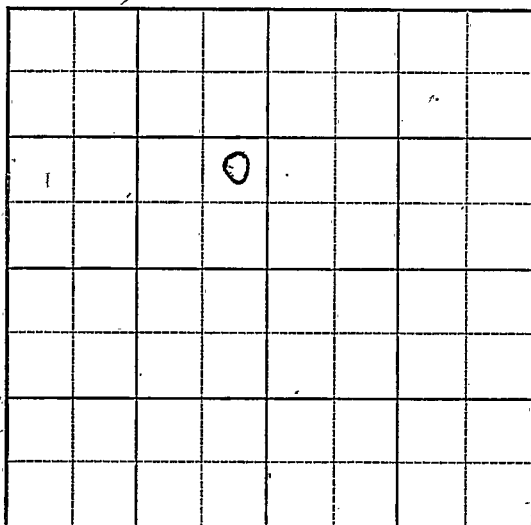

SOUTH

KANSAS

Rice County

Sec. 25 Twp. 19 R. 10-W

Well No. 4 Proffitt Farm

Harwood Oil etal. Company


Silica Pool

Ft. from N. Line

990 Ft. from S. Line

330 Ft. from E. Line

Ft. from W. Line

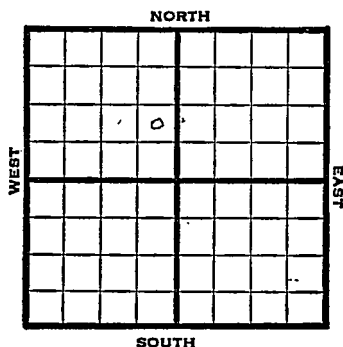

NE SE NW

1947 Elev. 1741 REPORT

8/20	Loc.
8/27	8" @ 228' Drlg. 1475'
9/3	Lansing 2947 BK' @ 3245 Arbuckle 3288-90 TD 5" @ 3288 Rust
9/10	"
9/17	"
9/24	SLM 3290-86' Arbuckle 3284' 5" @ 3284' TD 3289' 500 acid Swabb 2 $\frac{1}{2}$ bbls. oil PH
10/1	Arbuckle 3284 5" @ 3284 500 acid Bump 40 Pot TD 3289 Gravity 42

COMPLETED

OVER

1951

O.W.W.O.

5/2

Lans 2943' B KC 3241' Arb 3284'
5" @ 3284' OTD 3289' SP 3062'
8/3030-33' SO 500 A

5/9

Oil well TD 3062'
Lans. 2943' B KC 3241' Arb. 3284'
5" @ 3284' OTD 3289' SP 3062'
8/3030-33' SO 500 A
Comp. 5 BOPD 20 BW

COMPLETED

Map No. _____ Sec. 25 Twp. 19 R. 10W

Well No. 4 Proffitt

Harwood Oil etal. Company

FIRST REPORT

Contractor

NE SE NW


SECTION PLAT

_____ Ft. from N. Line

990 Ft. from S. Line

330 Ft. from E. Line

_____ Ft. from W. Line

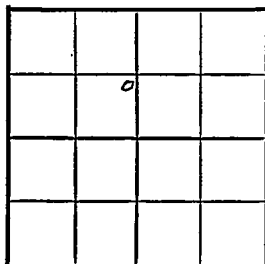

Rice County

Location X

Rig up _____

Drilling and Remarks:

RECORD

Cased _____ in., _____ ft.

Sand _____

Gas _____

Oil _____

Total Depth _____

PRODUCTION

1st 24 hrs. Nat. _____

1st 24 hrs. after shot _____

Gas _____ Cu. Ft.

Dry Hole _____

Abandoned _____

Date

AUG 20 1947 19

S. J. LEWIS

Scout

Wmap

Misc. Small Maps.

Cards

Tracing

France Map

Scarborough Map

Pierce Map

Geological Dept.

Pierce Plat Book

Map No. 46 Sec. 25 Twp. 19 R. 10W

Well No. 4 Proffitt

Harwood Oil etal. Company

COMPLETE

Contractor

NE SE NW

E11741
SECTION PLAT

	Δ		

 Ft. from N. Line

990 Ft. from S. Line

330 Ft. from E. Line

 Ft. from W. Line

Rice County

Location

Rig up

Drilling and Remarks:

Per 3284

5' @ 3284

500 cu. ft.

Pump 40 ft

42.2 lb

RECORD

Cased in., ft.

Sand

Gas

Oil

Total Depth 3289

PRODUCTION

1st 24 hrs. Nat.

1st 24 hrs. after shot

Gas Cu. Ft.

Dry Hole

Abandoned

Date

OCT 1 1947

19

S. J. LEWIS Scout

6m

Misc. Small Maps.....
Cards *Elaborate*
Tracing *Mr*
Grance Map *Mr*
Scarborough Map *Mr*
Pierce Map *Mr*
Geological Dept.
Pierce Flat Earth

Sec. 25 (Blk.) (Sur.) Map No.
(Twp.) (Rge.) 10W

Well No. 4 Farm Proffitt

Elev.	1741	Location	NE SE NW
-------	------	----------	----------

0

FIRST REPORT

990 Ft. From S Line NW

	Ft. From	Line	Quarter
530			

1st. Report **MAY 2 1951**

Completion **O.W.W.O.**

Remarks OK

Spudding Date _____

Drlg. Data _____

~~Lans. 2943 B KC 3241 Arb. 3284~~

~~5" @ 3284 OTD 3289 SR 3062 8/ 3030-55~~

SO 500 A

J. E. 1 YRA

MAY 4 1951

Scout Cards *mm*

Land Small Map

Land Wall Map *5*

Tracings

France Map

Pierre Map

Misc.

Drig. Data

J. E. TYRA

Scout Cards	mm
Land Small Map	
Land Wall Map	33
Tracings	
France Map	
Pierce Map	
Misc:	

MAY 15 1951

Drig. Data