

KANSAS

Rice

Section 25 Township 19 Range 10W

Well No. 5 Proffitt

Company Harwood Oil

Silica
NORTH

| | | | | | | | |
|--|--|---|--|--|--|--|--|
| | | | | | | | |
| | | 0 | | | | | |
| | | | | | | | |
| | | | | | | | |
| | | | | | | | |
| | | | | | | | |
| | | | | | | | |
| | | | | | | | |

WEST

EAST

SOUTH

KANSAS

Rice



Sec. 25 Twp. 19 R. 10W

Well No. #5 Proffitt Farm

Harwood Oil Company

Silica Pool (B & R Drlg., Cont.)


NORTH

990' Ft. from N. Line

_____ Ft. from S. Line

990' Ft. from E. Line

_____ Ft. from W. Line

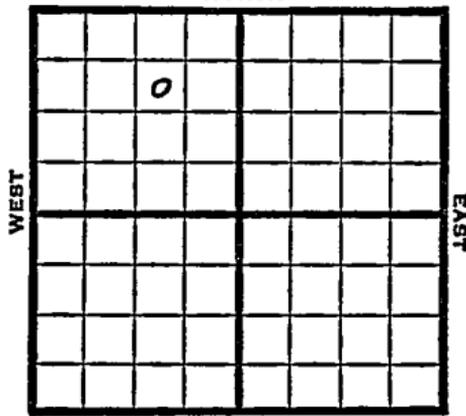

SW NE NW

SOUTH

1949 Elev 1740' REPORT

7/13 RUR
 7/20 8"@ 226'
 Lansing 2927'
 Drlg 2935'
 7/27 Arb 3261-62'
 5"@ 3261'
 8/3 TD 3272'
 Arb. 3260'
 5"@ 3261'
 Pump 190 Oil Pot
 42° Gr.
 Comp

COMPLETED

Kansas

Map No. _____ Sec. 25 Twp. 19 R. 10W

Well No. 5 Proffitt

Harwood Oil Company

B & R Drlg. Contractor

SW NE NW

FIRST REPORT
SECTION PLAT

990 Ft. from N. Line

_____ Ft. from S. Line

990 Ft. from E. Line

_____ Ft. from W. Line

| | | | |
|--|--|--|--|
| | | | |
| | | | |
| | | | |
| | | | |

Rice County

Location _____

Rig up _____

Drilling and Remarks:

R U R

RECORD

Cased _____ in., _____ ft.

Sand _____

Gas _____

Oil _____

Total Depth _____

PRODUCTION

1st 24 hrs. Nat. _____

1st 24 hrs. after shot _____

Gas _____ Cu. Ft.

Dry Hole _____

Abandoned _____

Date

JUL 13 1949 19 _____ S. J. LEWIS Scout

Map No. K 46 Sec. 25 Twp. 19 R. 10W

Well No. 5 Proffitt

Harwood Oil Company

COMPLETE

Contractor

SW NE NW

E 11740
SECTION PLAT

990 Ft. from N. Line

 Ft. from S. Line

990 Ft. from E. Line

 Ft. from W. Line

| | | | |
|--|---|--|--|
| | | | |
| | 0 | | |
| | | | |
| | | | |
| | | | |

Rice County

Location

Rig up

Drilling and Remarks:

CR 43260

5" @ 3261

Proffitt 190 oil Prod

42° SW

RECORD

Cased in., ft.

Sand

Gas

Oil

Total Depth 3272

PRODUCTION

1st 24 hrs. Nat.

1st 24 hrs. after shot

Gas Cu. Ft.

Dry Hole

Abandoned

Date

AUG 3 1949 19

S. J. LEWIS Scout