


Section 25 Township 19 Range 2-W

Well No. 1 Krehbiel

Company L. M. Reynolds et al

NORTH Ritz Canton Pool

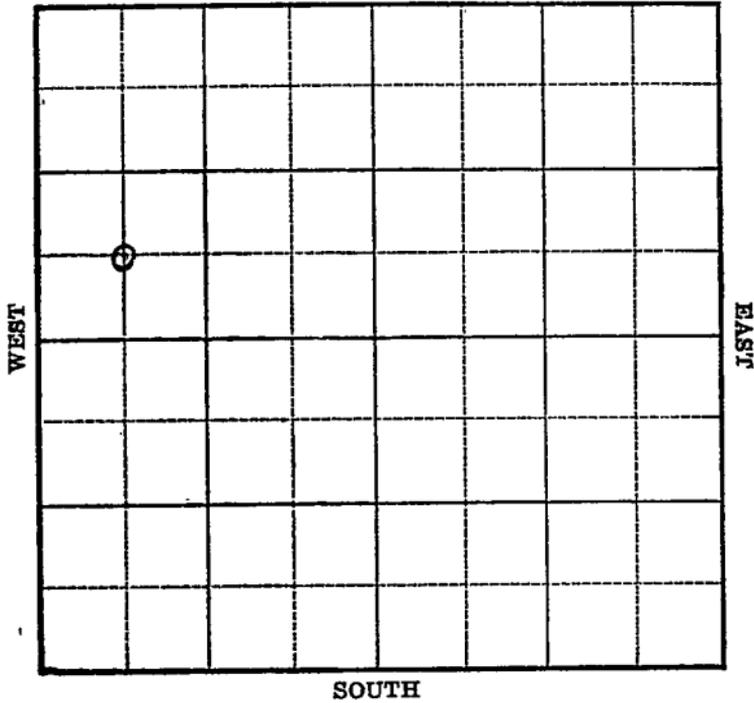

Sec. 25 Twp. 19 R. 2-W

Well No. #1 Krehbiel Farm

L. M. Reynolds et al. Company

(Ritz Canton)


_____ Ft. from N. Line

660 Ft. from S. Line

_____ Ft. from E. Line

660 Ft. from W. Line

Elev. 1544

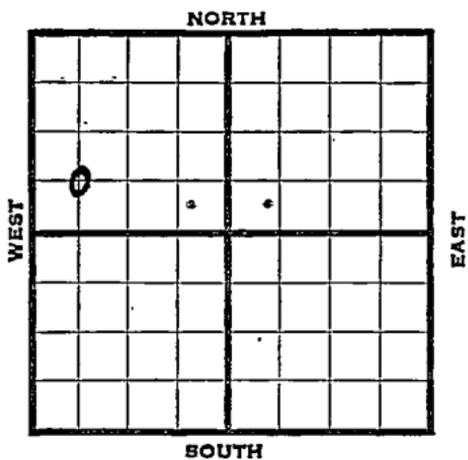

1939	REPORT
4/26	Machine.
5/5	Rigging up.
5/12	" "
5/19	" "
5/26	SD.
6/7	"
6/8	"
6/16	"
6/23	"
6/29	15" - 65' Drlg. 750'
7/6	12" - 403' Drlg. 425'
7/13	Drlg. 1030'
7/20	SD 1275'
7/27	"
8/3	"
8/10	"
8/17	"
8/24	"
8/31	"
9/7	"
9/14	10" - 1270' Drlg. 1390'

OVER

1939

9/21 Drlg. 1850'
9/28 2005' run 8".
10/5 2245' U.R. 8".
10/12 8" - 2220' Drlg. 2335'
10/19 K. C. 2335' Drlg. 2500'
10/26 SD 2500'
11/2 "
11/9 "
11/16 "
11/23 "
11/29 "
12/7 "
12/14 "
12/21 "
12/28 "

1940

1/4 "
1/11 "
1/18 6" - 2400'
T.D. 2500' C.O.
1/25 TD 2500' SD.
2/1 " "
2/8 2500' U.R. 6".
2/15 6" - 2455' C.O.
2/23 C.O. 2620'
2/29 Fsg. 2700'
3/8 Drlg. 2830'
3/14 Miss. & 5" - ~~2920'~~^{2910'} TD.
Shut down.
3/21 " "
3/28 " "
4/4 Miss. 2910' (Corrected)
5" - 2910' Coring 2913'
4/12 Pay 2944-55' T.D.
1000' oil.
4/18 T.D. 2959' 1500' oil.

OVER

1940
4/25

T.D. 2962' Swab 30 oil & 15
water 8 hours.

5/1

Miss. 2910'
5" - 2910'
T.D. 2962'
Pump 342 bbls.

COMPLETED

McPherson

KANSAS

Map No. 43 Sec. 25 Twp. 19 R. 2WWell No. 1 KrehbielL. M. Reynolds etal Company

Contractor

SECTION PLAT

0 SW NW

 Ft. from N. Line660 Ft. from S. Line Ft. from E. Line660 Ft. from W. Line

0			

RITZ CANTON POOL

Location Rig up

Drilling and Remarks:

Mach.

RECORD

Cased in., ft.Sand Gas Oil Total Depth

PRODUCTION.

1st 24 hrs. Nat. 1st 24 hrs. after shot Gas Cu. Ft.Dry Hole Abandoned

Date

4-28 19 39 H. D. H. Scout

Misc. Small Maps	<i>RAY</i>
Cards	<i>Paul</i>
Tracing	<i>Joe</i>
France Map	<i>RAY</i>
Scarborough Map	<i>RAY</i>
Moody Map	<i>RAY</i>
Geological Dept.	<i>RAY</i>
Moody Flat Book	<i>RAY</i>

Map No. 43 Sec. 25 Twp. 19 R. 2WWell No. 1 KrehbielL. M. Reynolds etal Company~~COMPLETED~~ Contractor

SECTION PLAT

C SW NW

_____ Ft. from N. Line

660 Ft. from S. Line

_____ Ft. from E. Line

660 Ft. from W. Line

o			
*			

RITZ-CANTON POOL

Location _____

Rig up _____

Drilling and Remarks:

*Miss 2910**5" @ 2910**Pump 342 P & T*

RECORD

Cased _____ in., _____ ft.

Sand _____

Gas _____

Oil _____

Total Depth 2962

PRODUCTION

1st 24 hrs. Nat. _____

1st 24 hrs. after shot _____

Gas _____ Cu. Ft.

Dry Hole _____

Abandoned _____

Date

MAY 1 1940₁₉S. I. LEWIS Scout

Misc. Small Maps
Cards
Tracing
France Map
Scarborough Map
Moody Map
Geological Dept.
Moody Flat Book