


McPherson

Form 51-5M-11-31-Palace

Map No. KANSAS Sec. 25 Twp. 19 R. 2W

Well No. 35 Freshbill Farm
Wolf Creek & Sinclair Prairie Company

NORTH

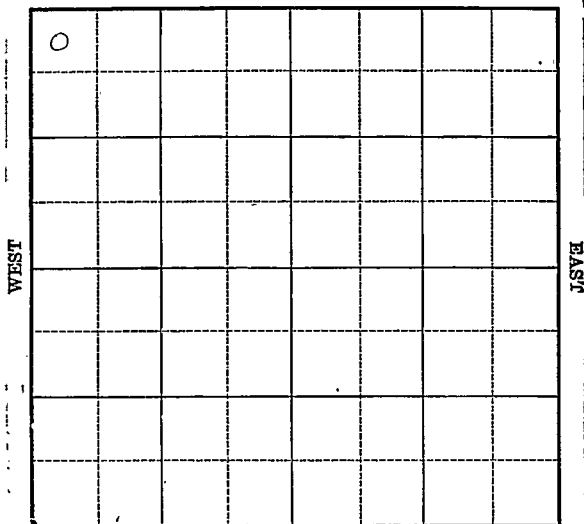

SOUTH

OWDD

Location

Drilling Remarks

Rig Up

Drilling Remarks

RECORD

Cased in. ft.

Sand

Gas

Oil

Total Depth

PRODUCTION

1st 24 hrs. Nat.

1st 24 hrs. after shot

Gas cu. ft.

Dry Hole

Abandoned

Map No. KANSAS Sec. 25 Twp. 19 R. 2^w

Well No. 3-Krehbiel Farm

Wolf Creek and Sinclair Company
NORTH Prairie


330 Ft. from N. Line

_____ Ft. from S. Line

_____ Ft. from E. Line

330 Ft. from W. Line

1932

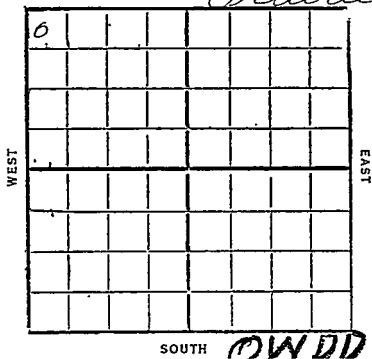

Date	REPORT
8/10	Pos.
8/17	
8/24	Bldg rig
8/31	Rig
9/7	Spdly 50'
9/14	20"-70
	75"-440
	drdg 945'
9/21	TD 945 Re-bldg rig
9/30	
10/5	Drldg 1420'
10/12	" 1900'
10/19	HFW 2120-2205
	10"-2170
	TD 2293
10/26	UIC 10"-2440'
11/2	10"-2440
	drldg 2890'
11/9	Log Chat 2924
	set 8" & 510
11/16	TD 2973 swabbing
	No test

- 11/23- TD 2973
swab 10 bbl per hour
- 11/30- TD 2973
swab 250 bbl oil &
show water 12 hrs
- 12/7- TD 2973
pump 125 bbl 10 hr
15% water
- 12/14- TD 2973
pump 7 1/6 bbl 24 hr
Not comp.
- 12/21- 8"-2924
Chat 2924-73
TD 2973
Pump 7 1/6 bbls oil &
25 bbl water
Comp.
- 1933 O.W.D.
- 8/23- DIG. 3200'
- 8/30 " 3320'
- 9/6 cor. 6" at 3394 - Top Viola 3394
TD 3395 W.O.C.S.
- 9/13 TD 3400 - swab 4 bbls per hr
will acidize
- 9/20- Top Viola 3394
T. D. 3400
1000 gallon acid
150 bbls 10 hrs
3% water

COMPLETED

McPherson

43 KANSAS

Map No. _____ Sec. 25 Twp. 19 R. 2 W

Well No. 3 Krehbier

No. 1 Creek & Sinclair Prairie Company

Contractor

FIRST REPORTS

330 Ft. from N. Line

_____ Ft. from S. Line

_____ Ft. from E. Line

330 Ft. from W. Line

SECTION PLAT

0			

Location _____

Rig up _____

Drilling and Remarks:

R.O.G.

RECORD

Cased _____ in., _____ ft.

Sand _____

Gas _____

Oil _____

Total Depth _____

PRODUCTION

1st 24 hrs. Nat. _____

1st 24 hrs. after shot _____

Gas _____ Cu. Ft.

Dry Hole _____

Abandoned _____

Date

AUG 10 1932

192

CHAS. L. SHERWOOD

Scout

Dr. J. C. Moore

R	1	<i>Dr. J. C. Moore</i>
S		
Lang		<i>ack</i>
France Map		<i>+</i>
Scarborough Map		<i>/</i>
Moody Map		<i>+</i>
Scarborough Plat Book		
Moody Plat Book		

43

KANSAS

Map No. _____ Sec. 25 Twp. 19 R. 2

Well No. 3 Krehbie

Wolf Creek-Dunclaire-Prairie Company

Contractor

COMPLETED

330 Ft. from N. Line

Ft. from S. Line

Ft. from E. Line

330 Ft. from W. Line

SECTION PLAT

0			

Location _____

Rig up _____

Drilling and Remarks:

Pump 716 Bes
25 Bes Nater

RECORD

Cased 8 in., 2974 ft.

Sand 2974-2973

Gas _____

Oil _____

Total Depth 2973

PRODUCTION

1st 24 hrs. Nat. _____

1st 24 hrs. after shot _____

Gas _____ Cu. Ft.

Dry Hole _____

Abandoned _____

Date

DEC 2 1 1932

CHAS. L. SHERWOOD

192

Scout

Handwritten scribbles and lines at the top of the page.

Returned	<i>[initials]</i>
Cards	<i>[initials]</i>
Tracing	<i>[initials]</i>
France Map	<i>[initials]</i>
Scarborough Map	<i>[initials]</i>
Moody Map	<i>[initials]</i>
Scarborough Port Book	<i>[initials]</i>
Moody Port Book	<i>[initials]</i>

Mephereson
 Map No. *43* Sec. *25* Twp. *19* R. *2W*
 Well No. *3-Krehbiel*
Wolfe Creek Company
 Contractor

SECTION PLAT


330 Ft. from N. Line

..... Ft. from S. Line

..... Ft. from E. Line

330 Ft. from W. Line

FIRST REPORTS

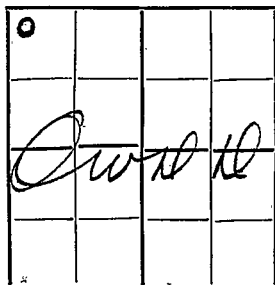

Location.....

Rig up.....

Drilling and Remarks:

RECORD

Cased.....in.,ft.

Sand.....

Gas.....

Oil.....

Total Depth.....

PRODUCTION

1st 24 hrs. Nat.....

1st 24 hrs. after shot.....

Gas.....Cu. Ft.

Dry Hole.....

Abandoned.....

Date

8/23/33 192 *Omannsch* Scout

Small
wall map

Returned	
Cards	<i>[initials]</i>
Tracing	<i>[initials]</i>
France Map	<i>[initials]</i>
Scarborough Map	<i>[initials]</i>
Moody Map	<i>[initials]</i>
Scarborough Flat Book	
Moody Flat Book	

McPherson
 Map No. 43 Sec. 25 Twp. 19 R. 2W

Well No. 3-Krehbiel

Wolfe Creek Company

Contractor

SECTION PLAT

0			

230 Ft. from N. Line

..... Ft. from S. Line

..... Ft. from E. Line

330 Ft. from W. Line

COMPLETED

Location.....

Rig up.....

Drilling and Remarks:

1000 gal. acid

150 3% water

10 hours

RECORD

Cased..... in. ft.
 Sand Viola L. 3394
 Gas.....
 Oil.....
 Total Depth 3400

PRODUCTION

1st 24 hrs. Nat.....
 1st 24 hrs. after shot.....
 Gas..... Cu. Ft.
 Dry Hole.....
 Abandoned.....

Date

7/20/33 O. Mannschreck Scout

Returned _____
Cards _____
Tracing _____
France Map _____
Scarborough Map _____
Moody Map _____
Scarborough Plat Book _____
Moody Plat Book _____