



Map No. KANSAS Sec. 25 Twp. 19 R. 2<sup>w</sup>

Well No. 2 - Stuffed Farm  
Lario & Steel Company


\_\_\_\_\_ Ft. from N. Line

330 Ft. from S. Line

\_\_\_\_\_ Ft. from E. Line

330 Ft. from W. Line

1931

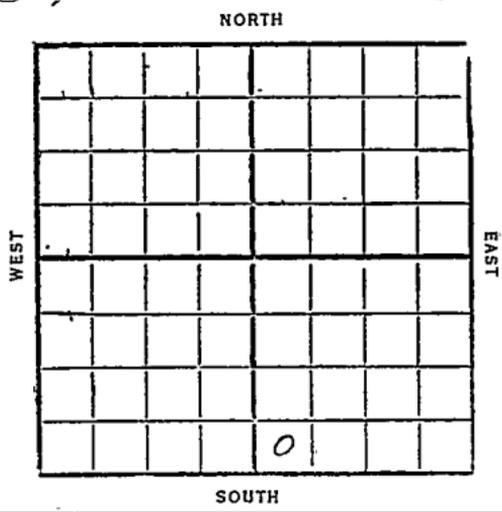

Date	REPORT	O. V. P. B.
5/7	Loc	
5/13	Bldg rig	
5/20	Run up	
5/27	Wind up & 510	
6/3	drlg 430'	
6/10	" 1310'	
6/17	" 1970'	
6/24	T.D. 2248	
	UIR 10" - 2098	
7/1	8" - 2461	
	HFV 2420	
	drlg 2665	
7/8	Top Chat 2924'	
	Show oil 2957'	
	HFV 2967'	
	hd slg. 3025'	
7/15	UIR 16" at 3130'	
7/22	sem 6" - 3095	
	Clg out	
7/29	Viola 3384 - 94 T.D.	
	flow 80 bbls per hr for 3 hrs	
	shot 15 qt 3384 - 92	
	Clg. out	

8/4 Viola 3384-94  
T.D. 3394  
shot 15 qt 3384-92  
1243 bbl oil  
potential  
Comp.

1938

O. W. P. B.

10/19 Old T.D. 3394' in Viola.  
P. B. to 2994'.  
Chat. 2924'.  
40 shots 2938-68'.  
Potential 108 bbls. No water.

FIRST REPORT

*and*  
COMPLETED

McPherson

43 KANSAS

Map No. \_\_\_\_\_ Sec. 25 Twp. 19 R. 2 W

Well No. 2 *Bayfield*

*Lario & Sheel* Company

Contractor

FIRST REPORTS

SECTION PLAT

		0	

\_\_\_\_\_ Ft. from N. Line

330 Ft. from S. Line

\_\_\_\_\_ Ft. from E. Line

330 Ft. from W. Line

Location

Rig up

Drilling and Remarks:

RECORD

Cased \_\_\_\_\_ in., \_\_\_\_\_ ft.

Sand \_\_\_\_\_

Gas \_\_\_\_\_

Oil \_\_\_\_\_

Total Depth \_\_\_\_\_

PRODUCTION

1st 24 hrs. Nat. \_\_\_\_\_

1st 24 hrs. after shot \_\_\_\_\_

Gas \_\_\_\_\_ Cu. Ft.

Dry Hole \_\_\_\_\_

Abandoned \_\_\_\_\_

Date

MAY 7 1931

CHAS. L. SHERWOOD

192

Scout

*James*  
*W. S.*

Returned.....	<i>JS</i>
Cards.....	<i>JS</i>
Tracing.....	<i>JS</i>
France Map.....	<i>JS</i>
Scarborough Map.....	<i>JS</i>
Moody Map.....	<i>JS</i>
Scarborough Plat Book.....	
Moody Plat Book.....	

*McPherson*

*43*

**KANSAS**

Map No. \_\_\_\_\_ Sec. *25* Twp. *19* R. *2*<sup>W</sup>

Well No. *2* *Buggies*

*Lario & Sheel* Company

Contractor

**COMPLETE**

**SECTION PLAT**

.....Ft. from N. Line

*330* Ft. from S. Line

.....Ft. from E. Line

*330* Ft. from W. Line


Location.....

Rig up.....

Drilling and Remarks:

*15/3384-92*

*Potential*  
*1243 lbs*

**RECORD**

Cased ..... in. .... ft.

Sand *Vida 3384-94*

Gas.....

Oil.....

Total Depth *3394*

**PRODUCTION**

1st 24 hrs. Nat.....

1st 24 hrs. after shot.....

Gas..... Cu. Ft.

Dry Hole.....

Abandoned.....

Date

**AUG 5 1931 CHAS. L. SHERWOOD**

192

Scout

*Journal*

Returned.....	<i>[Signature]</i>
Cards.....	<i>[Signature]</i>
Tracing.....	<i>[Signature]</i>
France Map.....	<i>[Signature]</i>
Scarborough Map.....	<i>[Signature]</i>
Moody Map.....	<i>[Signature]</i>
Scarborough Plat Book.....	<i>[Signature]</i>
Moody Plat Book.....	<i>[Signature]</i>

Map No. 43 Sec. 25 Twp. 19 R. 2W

Well No. 2 Suffield

Lario Company

Contractor

**FIRST REPORT** *♀*  
**SW SE COMPLETED** SECTION PLAT

\_\_\_\_\_ Ft. from N. Line

330 Ft. from S. Line

\_\_\_\_\_ Ft. from E. Line

330 Ft. from W. Line

		0	

Location \_\_\_\_\_

**RECORD**

Cased \_\_\_\_\_ in., \_\_\_\_\_ ft.

Sand \_\_\_\_\_

Gas \_\_\_\_\_

Oil \_\_\_\_\_

Total Depth \_\_\_\_\_

**PRODUCTION**

1st 24 hrs. Nat. \_\_\_\_\_

1st 24 hrs. after shot \_\_\_\_\_

Gas \_\_\_\_\_ Cu. Ft.

Dry Hole \_\_\_\_\_

Abandoned \_\_\_\_\_

Rig up \_\_\_\_\_

Drilling and Remarks:

OWPB-OTD 3394 in  
 Viola

PB 2994

Chat 2924

40 shots 2938-68

Pot. 108

no water

Date

OCT 19 1938

H. D. Hatfield

Scout

Misc Small Maps  
Cards  
Tracing  
Fi  
red

*Handwritten signatures and initials, including 'RDY' and 'Dri'.*

*Two long, diagonal handwritten lines with wavy ends, possibly representing a signature or a large mark.*

*Small handwritten text, possibly 'sh. 1. 1.'*