


McPherson  
Form 51-5M-1-30-38840

Map No. KANSAS Sec. 25 Twp. 19 R. 2<sup>w</sup>

Well No. 1 - Surfaced Farm  
Lario & Shell Company

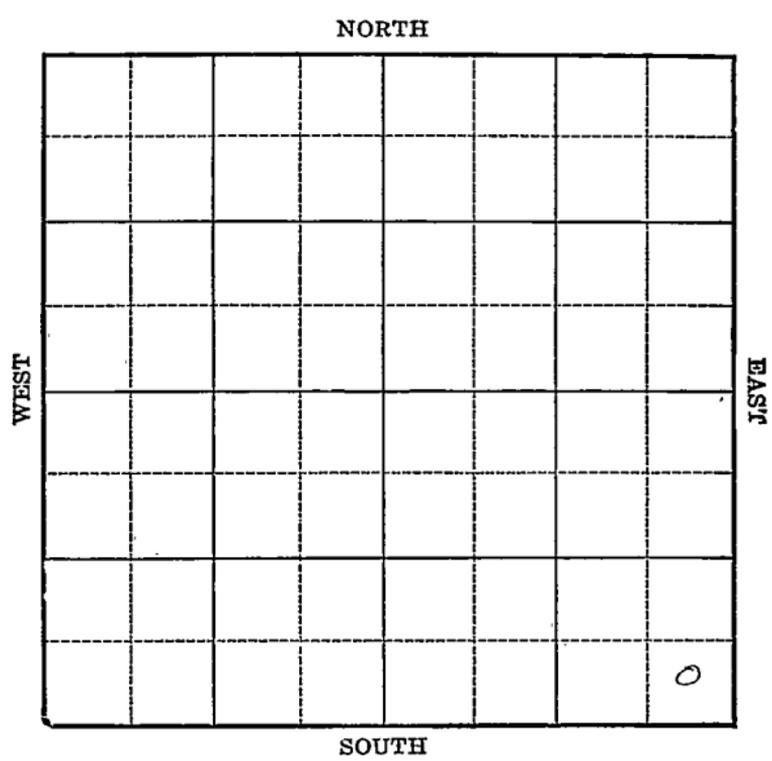

Location \_\_\_\_\_  
Drilling Remarks \_\_\_\_\_  
\_\_\_\_\_  
\_\_\_\_\_  
Rig Up \_\_\_\_\_  
Drilling Remarks \_\_\_\_\_  
\_\_\_\_\_  
\_\_\_\_\_  
**RECORD**

Cased \_\_\_\_\_ in. \_\_\_\_\_ ft.  
Sand \_\_\_\_\_  
Gas \_\_\_\_\_  
Oil \_\_\_\_\_  
Total Depth \_\_\_\_\_

**PRODUCTION**

1st 24 hrs. Nat. \_\_\_\_\_  
1st 24 hrs. after shot \_\_\_\_\_  
Gas \_\_\_\_\_ cu. ft. \_\_\_\_\_  
Dry Hole \_\_\_\_\_  
Abandoned \_\_\_\_\_

Map No. KANSAS Sec. 25 Twp. 19 R. 2<sup>w</sup>


Well No. 1 - Cuffield Farm  
Lario & Shell Company

         Ft. from N. Line

330 Ft. from S. Line

330 Ft. from E. Line

19.31 Ft. from W. Line

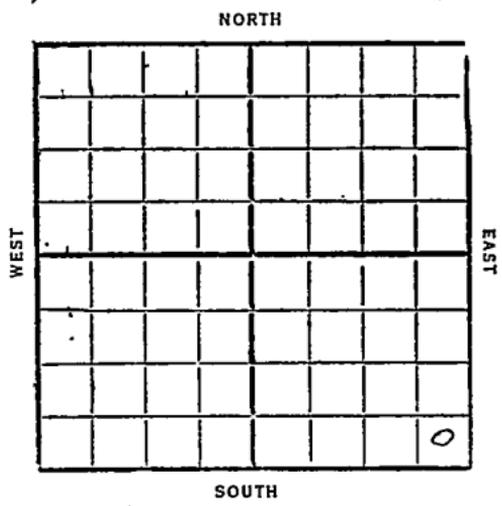

Date	REPORT
2/18	Log
2/25	Log
3/4	Spud
3/11	
3/18	Drlg 990'
3/25	" 1725'
4/1	" 2220'
4/8	10" - 2274
	Drlg 2430'
4/15	Chrt 2928-29
	No show - 2 1/2" 8"
4/22	T.D. 2932 SD
	Est 4 ft Gas
4/29	Show oil 2950
	Drlg 3000'
5/6	" 3128'
5/13	Base line 3159
	Viola 3396-3406
	flow 70 bbl / hour
5/20	T.D. 3414' Viola
	shot 24 qt 3399-3413
	swab 125 bbl 2 hrs

5/27 Sand 3396-3414

T.D. 3414

shot 24 qt 3399-3413

2710 bbl oil

Potential prod  
Comp.

Map No. **KANSAS** Sec. 25 Twp. 19 R. 2 W

43  
Well No. 1 Bonnie 66

Lariv & Shell Company

Contractor

**SECTION PLAT**

			0

..... Ft. from N. Line

230 Ft. from S. Line

890 Ft. from E. Line

..... Ft. from W. Line

**FIRST REPORTS**

Location ✓

Rig up .....

Drilling and Remarks:

**RECORD**

Cased..... in., ..... ft.

Sand.....

Gas.....

Oil.....

Total Depth.....

**PRODUCTION**

1st 24 hrs. Nat.....

1st 24 hrs. after shot.....

Gas..... Cu. Ft.

Dry Hole.....

Abandoned.....

Date

FEB 1 3 1931  
1932

S. J. LEWIS Scout

*[Handwritten scribbles and lines]*

Returned	.....
Cards	..... <i>[Handwritten initials]</i>
Tracing	..... <i>[Handwritten initials]</i>
France Map	..... <i>[Handwritten mark]</i>
Scarborough Map	..... <i>[Handwritten mark]</i>
Moody Map	..... <i>[Handwritten mark]</i>
Scarborough Flat Book	.....
Moody Flat Book	.....

*McPherson*

*43* **KANSAS** Sec. *25* Twp. *19* R. *2* <sup>W</sup>

Well No. *1* *Dupuis*

*Laris & Shell* Company

Contractor

**COMPLETED**

..... Ft. from N. Line

*330* Ft. from S. Line

*330* Ft. from E. Line

..... Ft. from W. Line

**SECTION PLAT**

			0

Location.....

Rig up.....

Drilling and Remarks:

*Shot 24/3399-3413*

*Potential Prod  
2710 Bbls.*

**RECORD**

Cased..... in. .... ft.

Sand *3396-3414*

Gas.....

Oil.....

Total Depth. *3414*

**PRODUCTION**

1st 24 hrs. Nat.....

1st 24 hrs. after shot.....

Gas..... Cu. Ft.

Dry Hole.....

Abandoned.....

Date

*MAY 27 1931*

192 **CHAS. L. SHERWOOD**

Scout

*[Handwritten scribbles]*

Returned.....
Cards..... <i>[Handwritten initials]</i>
Tracing..... <i>[Handwritten initials]</i>
France Map..... <i>[Handwritten X]</i>
Scarborough Map..... <i>[Handwritten X]</i>
Moody Map..... <i>[Handwritten X]</i>
Scarborough Plat Book.....
Moody Plat Book.....