

Form 51--5M--2-29--34703

Map No. KANSAS Sec. 23 Twp. 19 R. 2

Well No. 8-12 Truck Farm

Mid-Continent Company

NORTH

A 6x6 grid with 'WEST' on the left and 'EAST' on the right. A small circle is in the bottom-left cell.

SOUTH

Location_____

Drilling Remarks

Rig Up.....

Drilling Remarks

RECORD

Cased.....in.ft.

Sand_____

Gas.....

Oil

Total Depth.....

PRODUCTION

1st 24 hrs. Nat. _____

1st 24 hrs. after shot.-----

Gas _____ cu. ft. _____

Dry Hole.....

Abandoned

Map No. KANSAS Sec. 25 Twp. 19 R. 2^w
Well No. 2- Ypruk Farm
Mid-Kansas Company

NORTH


 Ft. from N. Line

330 Ft. from S. Line

 Ft. from E. Line

340 Ft. from W. Line

1931

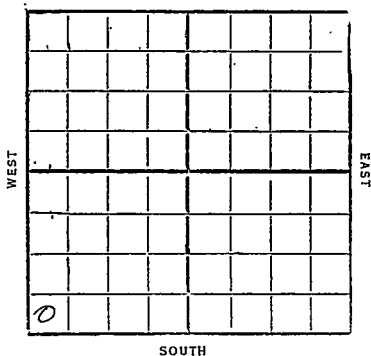

Date	REPORT
8/5	Loc
8/12	Bldg rig
8/19	rig
8/26	Drlg 575
9/2	12"-1369
	Drlg 1670'
9/9	HFw 1995-2055
	10"-2095
	Drlg 2245
9/16	10"-2291
	Drlg 2325'
9/23	" 2525'
9/30	Top chat 2902
	8"-2902
	show gas 2904-07
	drlg 2930'
10/7	show oil 2933
	HFw 2933-50
	base line 3120
	drlg 3125'
10/14	Top Viola 3375 773366
	109' oil in hole
	Rng 6" csq

10/21- Top Viola 3366 (52m)
6"- 3368

T.D. 3380

Swab 35 bbl per hr
shot 10 qt 3368-74

Have 2100 ft oil
Olg out

10/28- Cased 6"- 3368

Viola 3366-80

T.D. 3380

shot 10 qt 3368-74

Potential gauge
2469 bbl

Comp.

McPherson

 43
 Map No. **KANSAS** Sec. **25** Twp. **19** R. **2** W

 Well No. **2** *Unruh*
Miss. Kansas Company

Contractor

FIRST REPORTS

SECTION PLAT

Ft. from N. Line

330 Ft. from S. Line

Ft. from E. Line

340 Ft. from W. Line

0			

Location ✓

Rig up

Drilling and Remarks:

RECORD

Cased.....in.,ft.

Sand.....

Gas.....

Oil.....

Total Depth.....

PRODUCTION

1st 24 hrs. Nat.....

1st 24 hrs. after shot.....

Gas.....Cu. Ft.

Dry Hole.....

Abandoned.....

Date

AUG 5 1931

CHAS. L. SHERWOOD

192

Scout

Returned.....
Cards.....
Tracing.....
France Map.....
Scarborough Map.....
Moody Map.....
Scarborough Flat Book.....
Moody Flat Book.....

Map No. 43 **KANSAS** Sec. 25 Twp. 19 R. 2^W

Well No. 2 *mm*

Miss. Kansas Company

Contractor

COMPLETED

Ft. from N. Line

330 Ft. from S. Line

Ft. from E. Line

340 Ft. from W. Line

SECTION PLAT

Location

Rig up

Drilling and Remarks:

Shot 10/3368-74

Potential

2469 Bis.

RECORD

Cased 6 in., 3368 ft.

Sand icola, 3366-3380

Gas

Oil

Total Depth 3380

PRODUCTION

1st 24 hrs. Nat.

1st 24 hrs. after shot

Gas Cu. Ft.

Dry Hole

Abandoned

Date

OCT 28 1931

CHAS. L. SHERWOOD

192

Scout

17

Returned _____

Cards _____

Tracing _____

France Map _____

Scarborough Map _____

Moody Map _____

Scarborough Flat Book _____

Moody Plot Book _____