


Section 25 Township 19 Range 2W
Well No. #3 Unruh
Company Bradley & Tickel

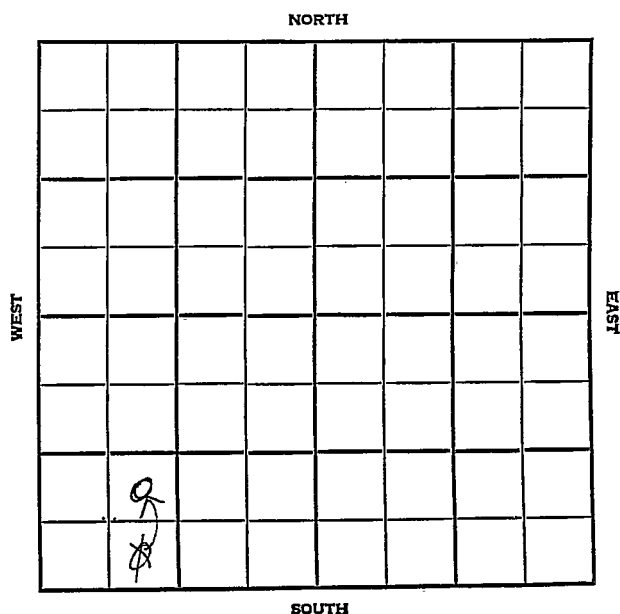

County McPherson Elev. _____
 Sec. 25 Twp. 19 Rge. 2W
 Company Bradley & Tickel
 Farm Name Unruh No. 3

TOPS	DEPTH	LOG	DATUM	Loc. in Sec.
Anh.				SE SW SW
Tr.				
H.				
Tr.				
Dg.				
Bl.				
L.				Geol. _____
K.C.				Contr. _____
B.K.C.				
Ce.				Mallard Tools
C.				
M.				Pool
M.				Ritz Canton
K.				
Mz.				
Mo.				
V.				
S.				
S.				
A.				
R.				
Pe.				
G.				
T.D.				

FIRST REPORT			
NOV 7 1938			
0			

Date Comm.

Location

22-11-38

22-11-38

CORRECTION

FORM 513 SUNRAY

County McPherson Elev. 1544 Co. 14
 Sec. 25 Twp. 19 Rge. 2W
 Company Bradley & Tickel
 Farm Name Unruh No. 3

TOPS	DEPTH	LOG	DATUM	Loc in Sec.
Anh.				SE SW SW NE
Ip.				
H.				
Tr.				
Dg.				
Bl.				
L.				Geol. _____
K.C.				Contr. _____
B.K.L.				Mallard Tool
Ce.				Pool _____
C.				Ritz Canton
M.	<u>chat</u>	<u>2914</u>		
M.				
K.				
Mz.				
Mo.				
V.				
S.				
S.				
A.				
R.				
PE.				
G.				
TD.		<u>2939</u>		

COMPLETE

DEC 13 '56

0

Date Comm.

Location NOV 13 '56 NOV 21 '56 11-15-56
8 5/8 155/116 D 2320 NOV 28 '56
5 1/2 2938/ co DEC 5 '56 DD 2947
TD FRAC DEC 13 '56 R. 10 BOPD
+ 80 % wtr.