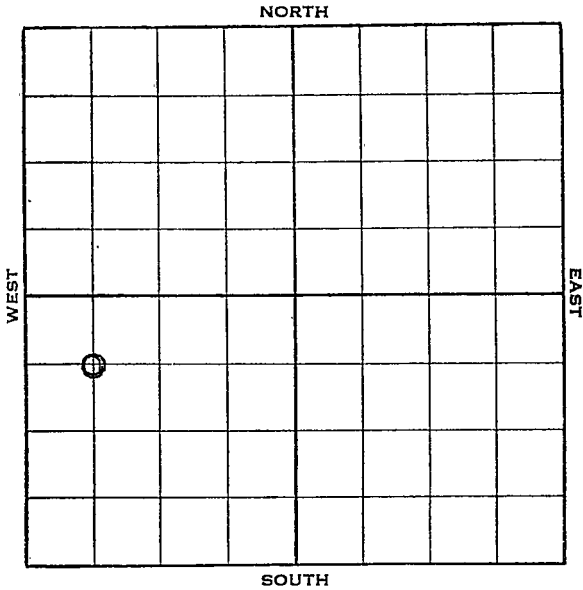
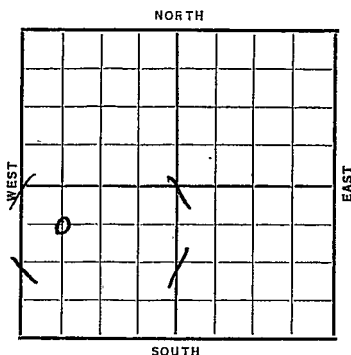


McPherson

Section 25 Township 19 Range 2-WWell No. 1 UnruhCompany Jess Cling et al

KANSAS

McPherson

Sec. 25 Twp. 19 R. 2-WWell No. #1 Unruh FarmJess Cling et al Company660 Ft. from N. Line Ft. from S. Line Ft. from E. Line660 Ft. from W. LineElev. 1538'.

Date

REPORT

1938

2/16

RUCT.

2/26

"

3/4

"

3/11

15" @ 100'. 13" @ 630'.

Drlg. 780'.

3/18

Drlg. 1475'.

3/25

Drlg. 2215'.

4/1

10" @ 1630'. K.C. 2310'.

8" @ 2312'. H.F.W. 2410-30'.

Drlg. 2558'.

4/8

6" @ 2615'. Chat 2910'.

S.G. 2910-12'. U. R. 6".

4/15

6" @ 2912'. Cleaning out.

4/22

T.D. 2953'. Swab 7 oil per hr.

Show water.

4/29

" " "

5/6

Pot. 68° oil. May acidize.

OVER

1938

5/10

6" @ 2912'.

Chat 2910'.

T.D. 2958'.

Potential 68 bbls. Nat'l.

COMPLETED


McPherson **KANSAS**Map No. _____ Sec. **25** Twp. **19** R. **2W**Well No. **1 Unruh****Jess Cling etal** Company

Contractor

FIRST REPORT**C NW SW****660** Ft. from N. Line

_____ Ft. from S. Line

_____ Ft. from E. Line

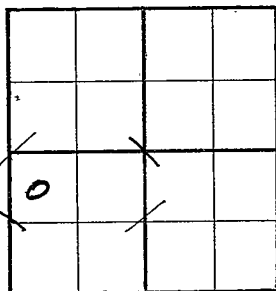660 Ft. from W. Line**SECTION PLAT**

Location _____

Rig up _____

Drilling and Remarks:

RUCT**RECORD**

Cased _____ in., _____ ft.

Sand _____

Gas _____

Oil _____

Total Depth _____

PRODUCTION

1st 24 hrs. Nat. _____

1st 24 hrs. after shot _____

Gas _____ Cu. Ft.

Dry Hole _____

Abandoned _____

Date

FEB 16 1938 19**H. D. Hatfield**

Scout

Heav.

Returned _____
Cards _____
Tracing _____
France Map _____
Scarborough Map _____
Moody Map _____
Scarborough Flat Book _____
Moody Flat Book _____

McPherson KANSAS

Map No. 43 Sec. 25 Twp. 19 R. 2WWell No. 1 UnruhJess Cling et al Company

Contractor

COMPLETED

C NW SW

660 Ft. from N. Line Ft. from S. Line Ft. from E. Line660 Ft. from W. Line

SECTION PLAT

0			

Location Rig up

Drilling and Remarks:

POT 68
Nat.
M

RECORD

Cased 6 in., 2912 ft.Sand CHAT 2910Gas Oil Total Depth 2958

PRODUCTION

1st 24 hrs. Nat. 1st 24 hrs. after shot Gas Cu. Ft.Dry Hole Abandoned

Date

MAY 10 1938

19

E. D. Hatfield Scout

RAY

Returned	
Cards	Paul
Tracing	Joe
France Map	
Scarborough Map	Ray
Moody Map	
Scarborough Plat Book	
Moody Plat Book	