

KANSAS

Form 51-5M-11-38-Palace


McPherson

Section 25 Township 19 Range 2-W

Well No. #1 Wiles

Company Bennett & Grossman

NORTH Ritz-Canton Pool

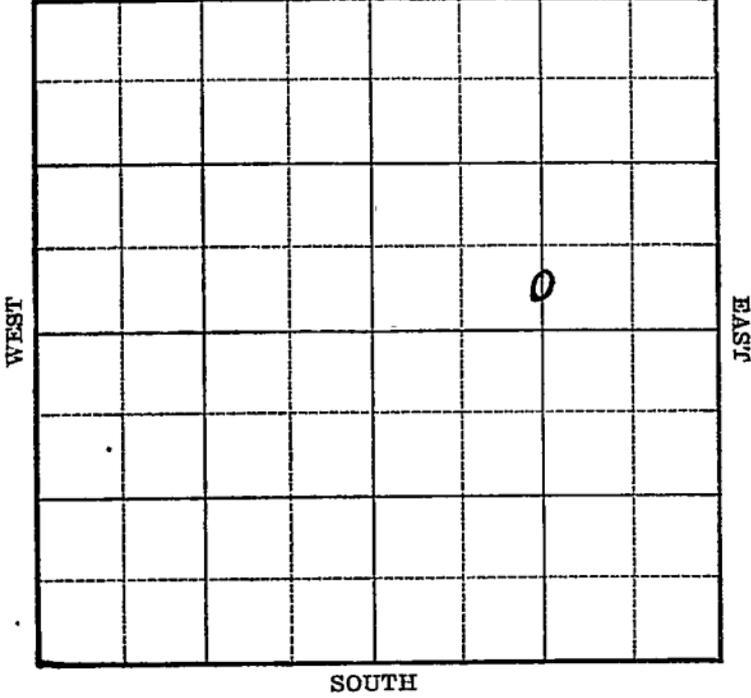

Sec. 25 Twp. 19 R. 2-W

Well No. #1 Wiles Farm

Bennett & Grossman Company

(Ritz-Canton)


 Ft. from N. Line

330 Ft. from S. Line

1320 Ft. from E. Line

 Ft. from W. Line

Elev. 1559

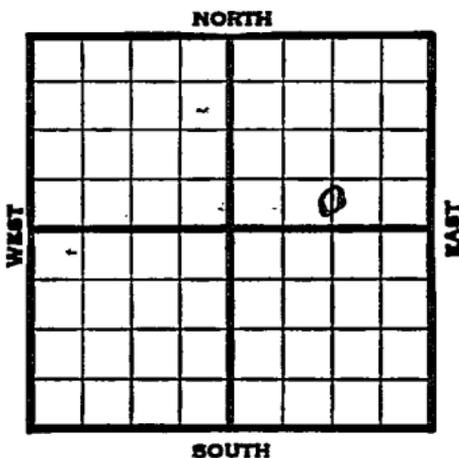

1939	REPORT
11/28	Cable.
12/7	Cable rig.
12/14	" "
12/21	Machine.
12/28	"
1940	
1/4	Dlg. 200'
1/11	15" - 83'
	Drlg. 815'
1/18	12" - 1045'
	Drlg. 1500'
1/25	Drlg. 2010'
2/1	SD 2010'
2/8	" "
2/15	10" - 2010'
	Drlg. 2300'
2/23	8" - 2360' T.D. 2470' SD.
2/29	Drlg. 2760'
3/8	Miss. 2948' 7" - 2945'
3/14	" " " "
	OVER

1940
3/21

Pay 2980-83' T.D. 2993'
Flow 50 bbls. 24 hours.

3/27

Miss. 2945'
7" - 2945'
T.D. 2993'
1000 acid.
Potential 253 bbls., pump.

COMPLETED

Map No. 43 Sec. 25 Twp. 19 R. 2WWell No. 1 WilesBennett & Grossman Company

Contractor

FIRST REPORT**C S L N E** Ft. from N. Line330 Ft. from S. Line1320 Ft. from E. Line Ft. from W. Line**RITZ-CANTON POOL****SECTION PLAT**

Location Rig up

Drilling and Remarks:

Cable**RECORD**Cased in., ft.Sand Gas Oil Total Depth **PRODUCTION**1st 24 hrs. Nat. 1st 24 hrs. after shot Gas Cu. Ft.Dry Hole Abandoned

Date

NOV 28 191919**S. J. LEWIS** Scout

Misc. Small Maps	RAY
Cards	RAY
Tracing	RAY
France Map	RAY
Scarborough Map	RAY
Moody Map	RAY
Geological Dept.	
Moody Flat Book	

Misc Small Maps	<i>DM</i>
Cards	<i>DM</i>
Tracing	<i>JW</i>
France Map	<i>DM</i>
Scarborough Map	<i>DM</i>
Moody Map	<i>DM</i>
Geological Dept.	
Moody Flat Book	