

Map No. **KANSAS** Sec. 25 Twp. 19 R. 2^w

Well No. 1- Niles Farm
~~Turn Dredge~~ - Phillips & Shull Company
NORTH


_____ Ft. from N. Line

330 Ft. from S. Line

330 Ft. from E. Line

_____ Ft. from W. Line

1931

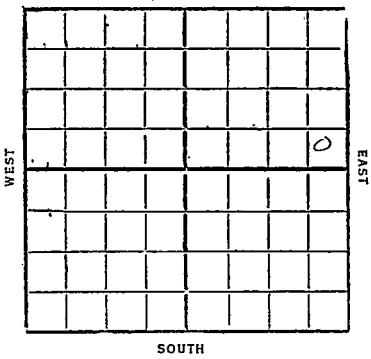

| Date | REPORT | O. W. P. B. |
|------|-------------------------------|-------------|
| 1/14 | Log | |
| 1/21 | Run up | |
| 1/28 | Spud | |
| 2/4 | Dredg 650' | |
| 2/11 | " 1215' | |
| 2/18 | " 1850' | |
| 2/25 | " 2255' | |
| 3/4 | " 2400' | |
| 3/11 | Run 8" - 2575' | |
| 3/18 | dredg 2896' | |
| 3/25 | Chat 2911 | |
| | dredg 2913 | |
| 4/1 | first show 2950 | |
| | TD. 2960 | |
| | flow 40 bbl/hr & quit flowing | |
| | May deepen | |
| 4/8 | Dredg 3010' | |
| 4/15 | SD 3010' | |
| 4/22 | 6" - 3105' | |
| | dredg 3110' | |
| | (over) | |

4/29- Base line 3145
U/R 6"- 3390'
5/6- S.D. 3391'
5/13- Csg trouble 3394
5/20- Viola 3397-3401
swab 556 bbl 11 hrs
5/27- T.D. 3403
swab 196 bbl 1 1/2 hrs
6/3- T.D. 3408" Viola
swab 109 bbl 1 hr
6/10- Viola 3397-3409
T.D. 3409
2464 bbl oil
potential gauge
Comp.

O. W. P. B.

1939
3/22

Old T. D. 3413'
Chat. 2911'
P. B. to 3003'
Ripped 7" - 2935-60'
Pump 11 oil, 180 water in 24 hrs.
P. B. to 2960'
Pump 39 oil, 35 water in 24 hrs.
Pump 18 bbls. 8 hrs.
Potential 54 bbls.

FIRST REPORT

and
COMPLETED

Form 26 - 11-13-28
M. H. Brown

Map No. **KANSAS** Sec. *25* Twp. *19* R. *2 W*

43
Well No. *1 of 125*

Twin Oil & Fuel Co. & Shell Company
Contractor

SECTION PLAT

| | | | |
|--|--|--|---|
| | | | |
| | | | |
| | | | 0 |
| | | | |
| | | | |

..... Ft. from N. Line
330 Ft. from S. Line
320 Ft. from E. Line
..... Ft. from W. Line

FIRST REPORTS

Location
Rig up
Drilling and Remarks:

RECORD

Cased..... in., ft.
Sand.....
Gas.....
Oil.....
Total Depth.....

PRODUCTION

1st 24 hrs. Nat.....
1st 24 hrs. after shot.....
Gas..... Cu. Ft.
Dry Hole.....
Abandoned.....

Date

JAN 14 1931

S. J. LEWIS Scout



| | |
|-------------------------|-------------------------------------|
| Retired | |
| Calls | <i>[Handwritten scribble]</i> |
| Tracing | <i>[Handwritten scribble]</i> |
| France Map | <i>[Handwritten scribble]</i> |
| Scarborough Map | <i>[Handwritten scribble]</i> |
| Moody Map | <i>[Handwritten scribble]</i> |
| Scarborough's Post Book | |
| Moody's Post Book | |

McPherson

Map No. **KANSAS** Sec. *35* Twp. *19* R. *2* ^W

Well No. *1* *Wales*

Wm Drey-Phillips & Sheer Company
 Contractor

COMPLETED

SECTION PLAT

.....Ft. from N. Line
330 Ft. from S. Line
330 Ft. from E. Line
Ft. from W. Line

| | | | |
|--|--|--|----------|
| | | | |
| | | | <i>0</i> |
| | | | |
| | | | |
| | | | |

Location.....
 Rig up.....
 Drilling and Remarks:

Potential
2464 Bbls.

RECORD

Cased..... in.,ft.
 Sand *Uola 3397-3409*
 Gas.....
 Oil.....
 Total Depth *3409'*


PRODUCTION

1st 24 hrs. Nat.....
 1st 24 hrs. after shot.....
 Gas..... Cu. Ft.
 Dry Hole.....
 Abandoned.....

Date

JUN 1 0 1931

CHAS. L. SHERWOOD
 Scout

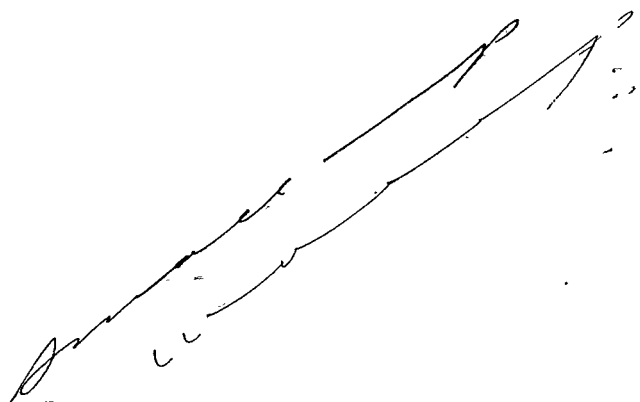

| | |
|-----------------------|--------------------|
| Returned | |
| Cards | <i>JG</i> |
| Tracing | <i>CPK</i> |
| France Map | <i>+</i> |
| Scarborough Map | <i>[Signature]</i> |
| Moody Map | <i>+</i> |
| Scarborough Plat Book | |
| Moody Plat Book | |

Map No. 43 Sec. 25 Twp. 19 R. 2W

Well No. 1 Wyles

Phillips & Shell Company

FIRST REPORT

Contractor

COMPLETED

SE NE

SECTION PLAT

| | | | |
|---|--|--|---|
| | | | |
| | | | o |
| . | | | |
| | | | |

_____ Ft. from N. Line

330 Ft. from S. Line

330 Ft. from E. Line

_____ Ft. from W. Line

RITZ CANTON POOL

Location _____

RECORD

Cased _____ in., _____ ft.

Rig up _____

Sand _____

Drilling and Remarks:

Gas _____

OWPB-OTD 3413

Oil _____

Chat 2911 P.B. 3003

Total Depth _____

Ripped 7" 2935-50

PRODUCTION

P/11 Oil, 180 Wat
in 24 Hrs.

1st 24 hrs. Nat. _____

1st 24 hrs. after shot _____

P.B. 2960

Gas _____ Cu. Ft.

P/39 Oil 35 Wat
in 24 Hrs.

Dry Hole _____

Abandoned _____

P- 18/8, Pot en. 54

Date

MAR 22 1913

H. D. Hatfield

Scout

Misc Small Maps.....
Cards.....
Tracing.....
France Map.....
Scarborough Map.....
Moody Map.....
Geological Dept.
Moody Plat Book