

Section 25 Township 19 Range 2 WWell No. # ⁵~~21~~ WilesCompany Bennett & Able

NORTH

					0		

WEST

EAST

SOUTH

McPherson

KANSAS


 Sec. 25 Twp. 19 R. 2 W

 Well No. # ⁵~~11~~ Wiles Farm

Bennett & Able

Company

Sunflower Drlg.

Contractor


Ritz- Canton Pool
990 Ft. from N. Line

_____ Ft. from S. Line

_____ Ft. from E. Line

990 Ft. from W. Line

SE NW NE

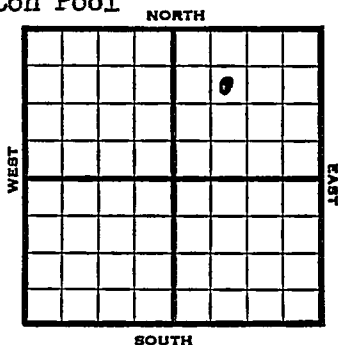

1953 Elev. 1556'

REPORT

6/17

RUR

6/21

8" @ 140'

KC 2308'

Drlg 2583'

7/1

RTD 2939

7" @ 2939'

DD 2956 S/ 1 boph / 25% w.

7/8

Spud 6-16-53

Oil Well

TD 2956

8" @ 140

KC 2308, Miss 2913

TD 2939

7" @ 2939, DD 2956

S/1 boph 25% wtr

Comp. 24 BOPD 20% wtr.

COMPLETED

J. G. McGEHEE

County McPherson State Kansas

Sec. 25 (Blk. Twp.) 19 (Sur. Rge.) 2W Map No.

Operator Bennett & Able

Well No. 5 Farm Wiles

Elev.	1556	Location	SE NW NE
-------	------	----------	----------

0

COMPLETE

990 Ft. From N Line NE

990 Ft. From W Line Quarter

1st. Report

Completion JUL 8 1953

Remarks Ritz-Canton Pool

Sunflower Drlg. - Contr.

Spudding Date 6-16-53

Drlg. Data Oil well TD 2956

8" @ 140 KC 2308 Miss. 2913

TD 2939 7" @ 2939 DD 2956

S/ 1 boph 25% wtr. Comp. 24 bopd 20% wt

Kansas

Map No. _____ Sec. 25 Twp. 19 R. 2WWell No. 5 Wiles

_____ Bennett & Able _____ Company

CORRECTION

_____ Contractor

SE NW NE

SECTION PLAT

990 Ft. from N. Line

_____ Ft. from S. Line

_____ Ft. from E. Line

990 Ft. from W. Line

		o	

McPherson County

Location _____

Rig up _____

Drilling and Remarks:

Reported
#11 Wiles

RECORD

Cased _____ in., _____ ft.

Sand _____

Gas _____

Oil _____

Total Depth _____

PRODUCTION

1st 24 hrs. Nat. _____

1st 24 hrs. after shot _____

Gas _____ Cu. Ft.

Dry Hole _____

Abandoned _____

Date

JUL 22 1953

19

J. G. McGEHEE Scout