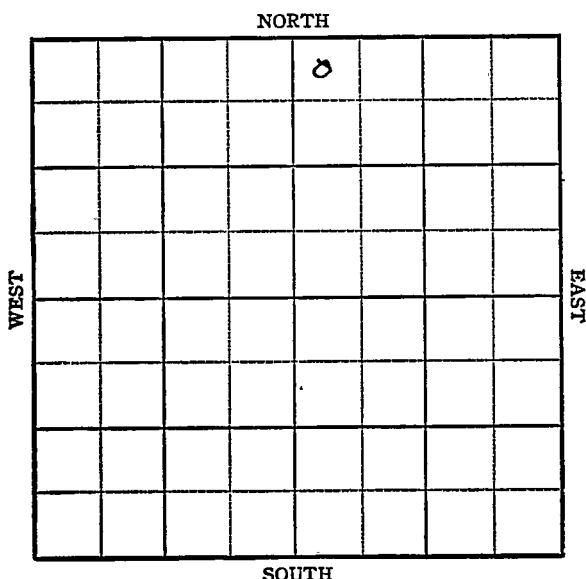


KANSAS

McPherson

Section 25 Township 19 Range 2WWell No. 4 Wiles "B"Company Mid-Western Pipe & Supply
Ritz-Canton

KANSAS

McPherson ✓

Sec. 25 Twp. 19 R. 2W

Well No. 4 Wiles "B" Farm

Mid-Western Pipe & Supply Company

Ritz-Canton


330 Ft. from N. Line

 Ft. from S. Line

 Ft. from E. Line

330 Ft. from W. Line

NW NE

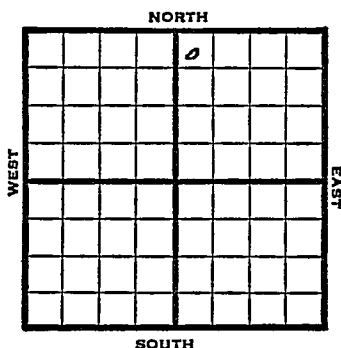

1948 Elev. 1555' REPORT

11/17 10" @ 148'
Drlg. 1685'
11/23 Drlg 2853'
11/30 Mississippi 2915'
5" @ 2937'
TD 2937'

12/6 Drlg. 2942
SO
12/15 TD 2968'
780' oil 8 hrs.

12/22 "
12/29 " ,

1949
1/5 Miss 2915'
5" @ 2987'
Pump 30 oil & 12 W Pot.
TD 2968'
Gr. 39°

COMPLETED

Map No. _____ Sec. 25 Twp. 19 R. 2W

Well No. 4 Wiles "B"

Mid-Western Pipe & Supply Company

FIRST REPORT

Contractor _____

NW NE

SECTION FLAT

330 Ft. from N. Line.

_____ Ft. from S. Line

_____ Ft. from E. Line

330 Ft. from W. Line

		6	

McPherson County

Location _____

Rig up _____

Drilling and Remarks:

10" @ 148

drlg. 1685

RECORD

Cased _____ in. _____ ft.

Sand _____

Gas _____

Oil _____

Total Depth _____

PRODUCTION

1st 24 hrs. Nat. _____

1st 24 hrs. after shot _____

Gas _____ Cu. Ft.

Dry Hole _____

Abandoned _____

Date

NOV 17 1948 19

S. J. LEWIS

Scout

Kansas

Map No. 43 Sec. 25 Twp. 19 R. 2WWell No. 4 Wiles "B"

Mid-Western Pipe & Supply Company


COMPLETE

Contractor

NW NE

E. 1558

SECTION PLAT

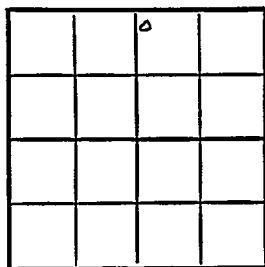330 Ft. from N. Line Ft. from S. Line Ft. from E. Line330 Ft. from W. Line

McPherson County

Location Rig up

Drilling and Remarks:

*Wils 2915**5" @ 2987**Run 3000 ft + 12 ft**P.D.**290 ft*

RECORD

Cased in., ft.Sand Gas Oil ✓Total Depth 2968

PRODUCTION

1st 24 hrs. Nat. 1st 24 hrs. after shot Gas Cu. Ft.Dry Hole Abandoned

Date

JAN 5 1949 19

S. J. LEWIS

Scout