

KANSAS

Form 51-5M-7-40-Palace


McPherson

Section 25 Township 19 Range 2-W

Well No. #3 Wiley "B"

Company Bennett & Grossman

NORTH Ritz Canton Pool

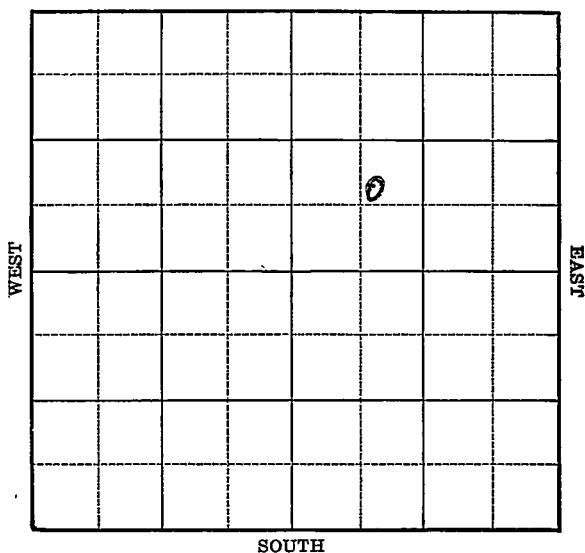


Sec. 25 Twp. 19 R. 2-WWell No. #3 Wiley "B" FarmBennett & Grossman Company

(Ritz Canton)

 Ft. from N. Line780 Ft. from S. Line Ft. from E. Line700 Ft. from W. Line

Elev. 1558

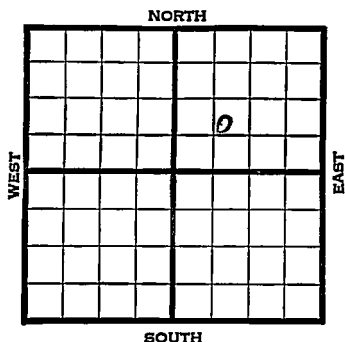

1940	REPORT
9/18	Cellar.
9/26	Machine.
10/3	15" - 80' Drlg. 440'
10/10	12" - 760' Drlg. 1325'
10/17	10" - 1637'
	SD 2005'
10/24	K.C. 2305' 8" - 2350'
	2460' U.R. 8".
10/31	8" - 2450' B.K.C. 2640'
	Miss. 2940' S. Gas 2940-45' TD
	Shut down.
11/7	T.D. 2985' Pump 50 bbls. day.
11/13	Miss. 2940'
	7" - 2945'
	T.D. 2985'
	1000 acid.
	Potential 216 bbls., pump, 5%
	water.
	COMPLETED

Map No. 43 Sec. 25 Twp. 19 R. 2WWell No. 3 Wiley "B"Bennett & Grossman Company

Contractor

FIRST REPORT

C SW NE

 Ft. from N. Line780 Ft. from S. Line Ft. from E. Line700 Ft. from W. Line

RITZ CANTON POOL

SECTION PLAT

		o	

Location Rig up

Drilling and Remarks:

Cellar

RECORD

Cased in., ft.Sand Gas Oil Total Depth

PRODUCTION

1st 24 hrs. Nat. 1st 24 hrs. after shot Gas Cu. Ft.Dry Hole Abandoned

Date

SEP 18 1940S. J. LEWIS Scout

Map No. 43 Sec. 25 Twp. 19 R. 2WWell No. 3 Willie "B"Bennett & Grossman Company

Contractor

COMPLETED

C SW N E

 Ft. from N. Line780 Ft. from S. Line Ft. from E. Line700 Ft. from W. Line

RITZ CANTON POOL

SECTION PLAT

		o	

Location Rig up

Drilling and Remarks:

*Miss 2940**7 "C 2945"**1000 acid**Pump 216 - 5 1/8 Water**R.D.***RECORD**Cased in., ft.Sand Gas Oil Total Depth 2985**PRODUCTION**1st 24 hrs. Nat. 1st 24 hrs. after shot Gas Cu. Ft.Dry Hole Abandoned

Date

NOV 13 1940

19

S. J. LEWIS Scout