

McPherson

KANSAS

25

19

2W


SECTION _____ TOWNSHIP _____ RANGE _____

#7 Krehbiel

WELL NO. _____

COMPANY _____ Bradley-Tickel

NORTH

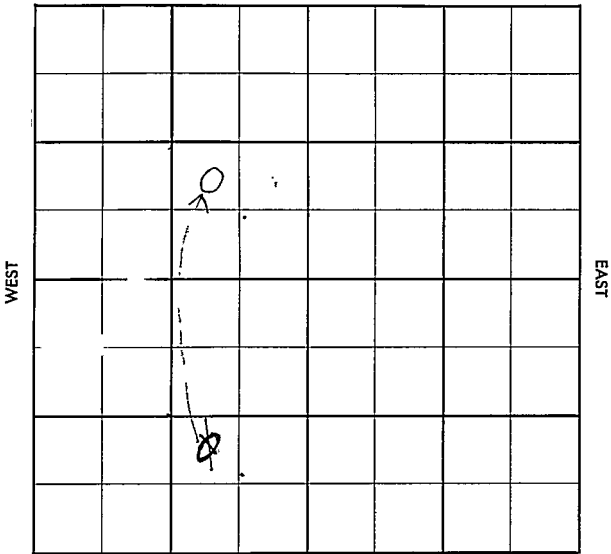

SOUTH

McPherson

SEC.	TWP.	R.
25	19	2W

WELL NO. #7 Krehbiel

COMPANY Bradley-Tickel

CONTRACTOR Galva


_____ FT. FROM N. LINE

_____ FT. FROM S. LINE

_____ FT. FROM E. LINE

_____ FT. FROM W. LINE

NW SE ~~SW~~ NW

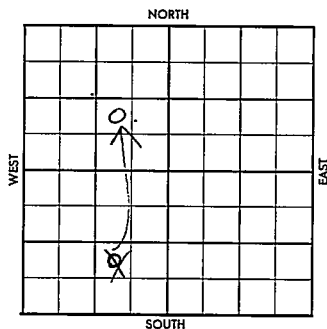

1956	ELEVATION	REPORT
------	-----------	--------

9-12 Loc

County Mc Pherson Elev. _____ Co.
 Sec. 25 Twp. 19 Rge. 2W
 Company Bradley-Tickel
 Farm Name Krehbiel No. 7

TOPS	DEPTH	LOG	DATUM	Loc. in Sec.
Anh.				NW SE SW
Tp.				
H.				
Tr.				
Dg.				
Bl.				
L.				Geol. _____
K.C.				Contr. _____
B.K.C.				
Ce.				
C.				
M.				
M.				Pool
K.				Galva
Mz.				
Ma.				
V.				
S.				
S.				
A.				
R.				
Pe.				
G.				
T.D.				

SEP 12 56
 FIRST REPORT
 D

Date Comm.

Location

60111 8 977

225 100

Co.

Lse.

No.

Sec.

T.

R.

CORRECTION

County Mc Pherson Elev. 1549DF
 Sec. 25 Twp. 19 Rge. 2W
 Company Bradley-Tickel
 Farm Name Krehbiel No. 7

TOPS	DEPTH	LOG	DATUM	Loc. in Sec.
Anb.				NW SE SW
TP				NW
H.				
Tr.				
Dg.				
Bl.				
L.	2308			
K.C.				Geol.
B.K.C.				Contr.
Ce.				
C.				
M.	2917			Pool
M.				Galva
K.				
Mz.				
Mo.				
V.				
S.				
S.				COMPLETE
A.				
R.				
Pe.				OCT 17 '56
G.				
TD.	2942			

Date Comm.

Location . SEP 19 '56 C & P SEP 26 '56 9-

20-56-8.98 157/100 ID 2308

OCT 3 '56 5 1/2 @ 2942 DD OCT 10 '56

OCT 17 '56 DD 2965 1/2 POP.

P. 12 Bopd + Trace wtr.