


Map No. KANSAS Sec. 25 Twp. 19 R. 2^W
Well No. 4-Krehbiel Farm
Hoff Creek & Sinclair Company
Prairie

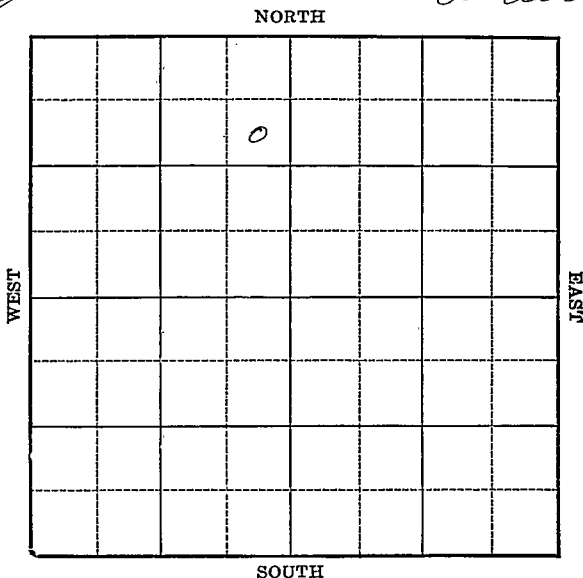

Location _____
Drilling Remarks _____

Rig Up _____
Drilling Remarks _____

RECORD

Cased _____ in. _____ ft.
Sand _____
Gas _____
Oil _____
Total Depth _____

PRODUCTION

1st 24 hrs. Nat. _____
1st 24 hrs. after shot _____
Gas _____ cu. ft. _____
Dry Hole _____
Abandoned _____

McPherson

Form 252-A
5M 4-32 MPC

Map No. KANSAS Sec. 25 Twp. 19 R. 2^W


Well No. 4 - Krekheil Farm
Wolf Creek & Inc. - Prairie Company

990 Ft. from N. Line

 Ft. from S. Line

330 Ft. from E. Line

 Ft. from W. Line

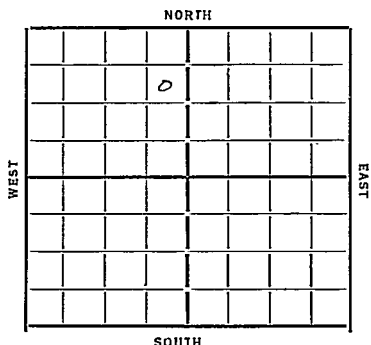

1932

Date

REPORT

12/7	Ops.
12/14	Bldg rig.
12/21	Rig
12/28	
1933	
1/4	15" - 391
	Dr'g 535'
1/11	" 1315'
1/18	12" - 1627
	3 bails water 1700
	Dr'g 1865'
1/25	10" - 2205
	U/R 10" - 2405'
2/1	
2/8	Top Chat 2915 2912
	show gas
	pulling big pipe
2/15	8" 2912
	show gas 2917
	stick oil 2946
	TD 2978
	swab 20 bbl oil + 20 bbl water
	per hour.

2/22-

8"-2912

Chat 2912-78

First gas 2917

" Oil 2946

TD 2978

Pump 75 bbl oil and
30 bbl water 24 hr

Comp.

McPherson

#3 KANSAS

Map No. Sec. 25 Twp. 19 R. 2 W

Well No. 4 Krehbiel

Woly Creek & Sinclair Prairie Company

Contractor

FIRST REPORTS

SECTION PLAT

	o		

990 Ft. from N. Line

Ft. from S. Line

330 Ft. from E. Line

Ft. from W. Line

Location

Rig up

Drilling and Remarks:

R.O.G.

RECORD

Cased in., ft.

Sand

Gas

Oil

Total Depth

PRODUCTION

1st 24 hrs. Nat.

1st 24 hrs. after shot

Gas Cu. Ft.

Dry Hole

Abandoned

Date

DEC 7 1932 CHAS. L. CHERWOOD

192

Scout

Small

Rye	
Cong	
Town	
France Map	
Scarborough	
Moody Map	
Scarborough	

Mc Pherson

43 KANSAS Map No. Sec. 25 Twp. 19 R. 2^W

Well No. 4 Krehbier

Noel Creek & Sinclair Prairie Company

Contractor

COMPLETED

990 Ft. from N. Line

Ft. from S. Line

330 Ft. from E. Line

Ft. from W. Line

SECTION PLAT

	10		

Location

Rig up

Drilling and Remarks:

1st gas 2917

1st gas 2944

Pump 75 lbs

30 lbs water

24 Hrs.

RECORD

Cased 8 in., 2912 ft.

Sand 2912-78

Gas

Oil

Total Depth 2978

PRODUCTION

1st 24 hrs. Nat.

1st 24 hrs. after shot

Gas Cu. Ft.

Dry Hole

Abandoned

Date

FEB 22 1933

CHAS. L. SHERWOOD

Scout

Handwritten signature

Returned	
Cards	<i>[Signature]</i>
Facing	<i>[Signature]</i>
France Map	<i>[Signature]</i>
Scarborough	<i>[Signature]</i>
Moody	<i>[Signature]</i>
Scarborough	<i>[Signature]</i>
Moody	<i>[Signature]</i>