

Mc Pherson

Map No. KANSAS Sec. 25 Twp. 19 R. 2^W


Well No. 5 Krehbiel Farm
Wolfe Creek Company

_____ Ft. from N. Line

660 Ft. from S. Line

660 Ft. from E. Line

_____ Ft. from W. Line

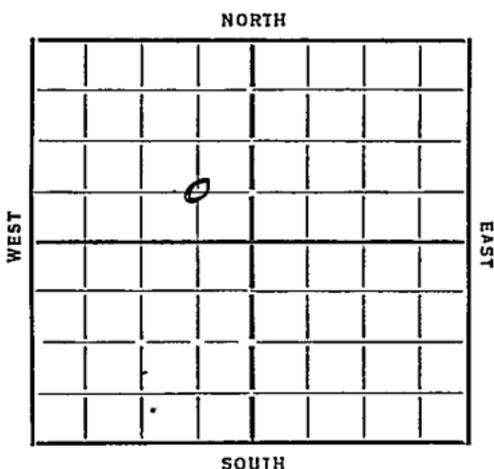

Date 7/9/34

REPORT

9/5 Spuds
9/13 Dlg 1775 10" 1000
9/20 8" 1790 HFW 2125-40
Dly 2185
9/27 T) 2290
10/4 Dly 2442 6" 2212
10/11 K.C. 2360 7 1/2" W 2440-47
T) 2456 W.B. 6"
10/18 Dly 2880
10/25 T.C. 2926 5" 2926 2975 T)
80 oil & 10 w. 24 hrs.
11/1 Testing
11/7 Chrt 2926 T) 2975
198 Bbls.

COMPLETED

[Handwritten scribbles and a long diagonal line]

1125	
...	
...	
...	

[Handwritten signature]

Map No. 143 Sec. 25 Twp. 19 R. 2W

Well No. 5-Krehpiel

Wolfe Creek Company

Contractor

COMPLETED

SECTION PLAT

..... Ft. from N. Line

660 Ft. from S. Line

660 Ft. from E. Line

..... Ft. from W. Line

RECORD

Location.....

Cased..... in. ft.

Rig up.....

Sand Chat 2926

Drilling and Remarks:

Gas.....

Oil.....

Total Depth 2975

198 bbls

PRODUCTION

1st 24 hrs. Nat.....

1st 24 hrs. after shot.....

Gas..... Cu. Ft.

Dry Hole.....

Abandoned.....

Date

ORVAL MANNSCHRECK

11-7-34

192..... Scout

Handwritten scribbles and lines, possibly a signature or initials, extending diagonally across the top half of the page.

Returned	<i>RS</i>
Cards	<i>RS</i>
Tracing	<i>RS</i>
France Map	<i>X</i>
Sea. borough Map	<i>RS</i>
Moody Map	<i>X</i>
Sea. borough Plot	
