

KANSAS


FORM 51 5M 4-41 PETROL

Mcpherson

Section 25 Township 19 Range 2-W

Well No. #1 Suffield

Company McKann Oil

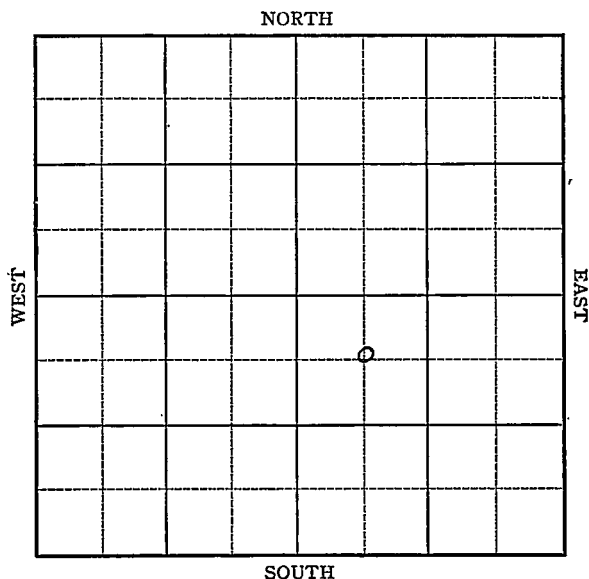

Sec. 25 Twp. 19 R. 2-W

Well No. #1 Sniffield Farm

McKann Oil _____ Company


(Ritz Canton)

660 Ft. from N. Line

_____Ft. from S. Line

Ft. from E. Line

660 Ft. from W. Line

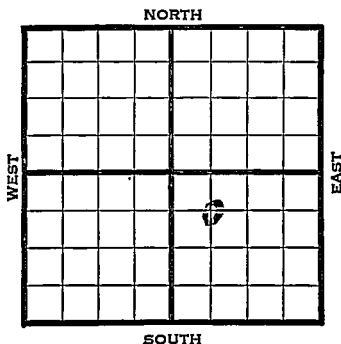[illegible]

Map No. 43 Sec. 25 Twp. 19 R. 2WWell No. 1 SuffieldMcKann Oil Company

Contractor

FIRST REPORT

C NW SE

660 Ft. from N. Line Ft. from S. Line Ft. from E. Line660 Ft. from W. Line**SECTION PLAT**

		0	

RITZ CANTON POOL**RECORD**Location Cased in., ft.Rig up Sand Drilling and Remarks: Gas Oil Total Depth 10" - 101Drlg. 2200**PRODUCTION**1st 24 hrs. Nat. 1st 24 hrs. after shot Gas Cu. Ft.Dry Hole Abandoned

Date

JUN 25 1941

19

S. J. LEWIS Scout

Map No. 43 Sec. 25 Twp. 19 R. 2WWell No. 1 SuffieldMcKann Oil CompanyCOMPLETED Contractor

SECTION PLAT

C NW SE

660 Ft. from N. Line Ft. from S. Line Ft. from E. Line660 Ft. from W. Line

RITZ CANTON POOL

		o	

Location Rig up

Drilling and Remarks:

*Miss 2904**7" @ 2922**2000 acut**Pump 100 oil 20 water**8X**4 1/2 Gr*

RECORD

Cased in., ft.Sand Gas Oil Total Depth 2974

PRODUCTION

1st 24 hrs. Nat. 1st 24 hrs. after shot Gas Cu. Ft.Dry Hole Abandoned

Date

JUL 23 1941 19 S. J. LEWIS Scout