


DX 78-1 McPherson

**KANSAS**

Section 25 Township 19 Range 2W

Well No. #6 Wiles

Company Western Pipe & Supply

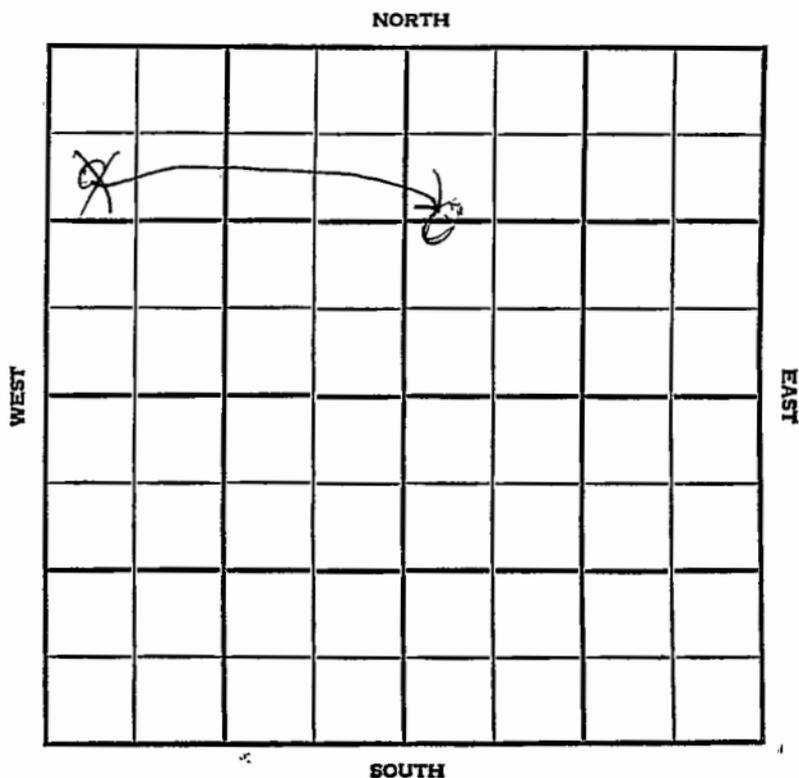

SEC. 25	TWP. 19	R. 2W
---------	---------	-------

WELL NO. #7  
#6 Wils FARM

COMPANY Western Pipe & Supply

CONTRACTOR Sunflower


Ritz-Canton  
1200 FT. FROM N. LINE

FT. FROM S. LINE

FT. FROM E. LINE

330 FT. FROM W. LINE

~~SW NW NW~~ OF NE/4  
W/2 W/2 NE

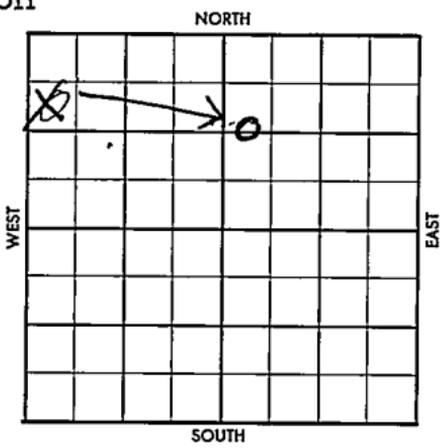

1956	ELEVATION 1550'	REPORT
------	-----------------	--------

8-22 Location

**COMPLETED**

## CORRECTION

FORM 513 SUNRAY

County McPherson Elev. 1550  
 Sec. 25 ~~Trp.~~ 19 Rgs. 27  
 Company Western Pipe & Supply  
 FarmName Wiles No. (87)

TOPS	DEPTH	LOG	DATUM	Log in Sec
Anb.				<u>W 2 W 2 NE</u>
Trp.				<u>SW NW NE</u>
H.				
Tr.				<u>1200 NL</u>
Dg.				<u>330 WL</u> OF N
Bl.				
L.				Geol. _____
K.C.				Contr. _____
B.K.C.				
Ce.				<u>Sunflower</u>
C.				
M. <u>chat</u>	<u>2909</u>			Pool _____
M.				<u>Ritz-Canton</u>
K.				
Mz.				
Mo.				
V.				
S.				<u>X</u> <u>&gt; 0</u>
S.				
A.				
R.				
PE.				<u>COMPLETE</u>
G.				
TR.	<u>2950</u>			<u>SEP 12 '56</u>

Date Comm.

Location AUG 8 '56 AUG 15 '56 AUG 22 '56  
8-18-56 ~~8-18-56~~ 20" @ 96/75-  
1710 AUG 29 '56 7" @ 2939  
CO 2950 200 acid SEP 5 '56 CO  
2950 200 Acid FU 250' oil +  
50 SW no time SEP 12 '56 P. 20  
B0 + 10 Bwpd.