


Section 25 Township 19 Range 2W

Well No. 6 Wildes

Company Western Pipe & Supply

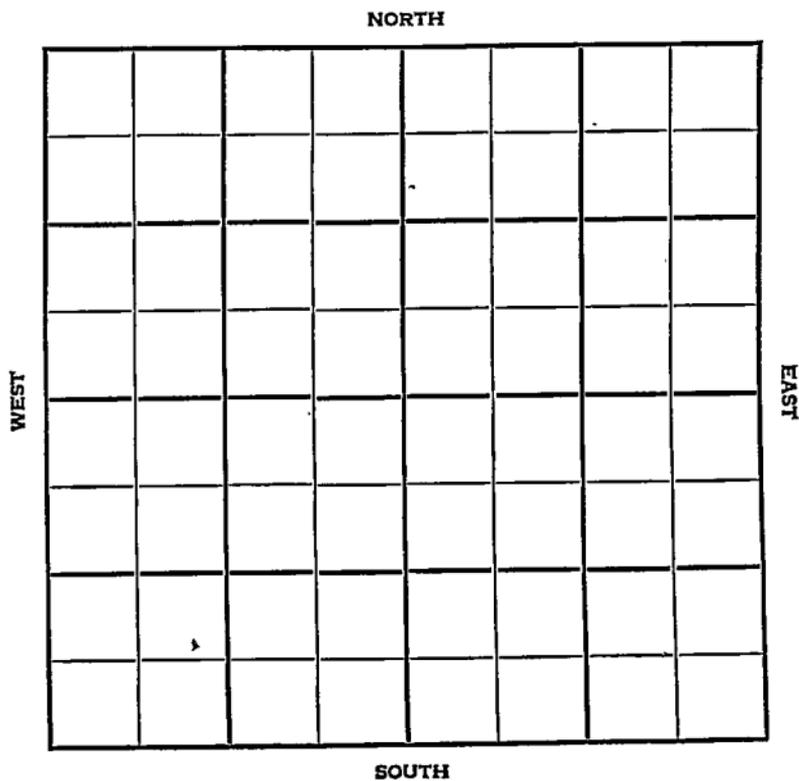


SEC.	TWP.	R.
25	19	2 W

WELL NO. # 6 Wildes FARM

COMPANY Western Pipe & Supply

CONTRACTOR

_____ Ft. from N. Line
 _____ Ft. from S. Line
 _____ Ft. from E. Line
 _____ Ft. from W. Line

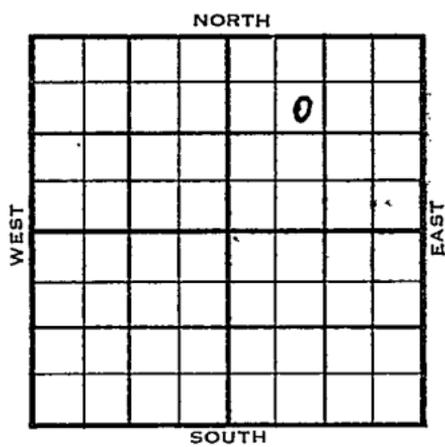

SE NW NE

1955	ELEVATION REPORT
7/13	<p>Comm. 6-23-55 10" @ 152/135 TD 2959' 7" @ 2952 DD 2961 FU 160' oil, 50' wtr. 12 hr. S/3/4 BO 1/4 BWPH Comp. 20 BOPD 5 BW KC 2308' M. 2925' TD 2959'</p> <p style="text-align: center;">FIRST REPORT ↓ COMPLETED</p>

County McPherson Elev. _____
 Sec. 25 Twp. 19 Rge. 2W
 Company Western Pipe & Supply
 Farm Name Wildes No. 6

TOPS	DEPTH	LOG	DATUM
Anh.			
TP.			
H.			
Tr.			
Dg.			
BL.			
L.			
K.C.	2308		
B.K.C.			
Ce.			
C.			
M.	2925		
M.			
K.			
Mz.			
Me.			
V.			
S.			
S.			
A.			
R.			
PE.			
G.			
TD.	2959		

Loc. in Sec. _____

SE NW NE

Geol. _____

Contr. _____

Pool _____

6'

COMPLETE
FIRST REPORT
JUL 13 '55

Date Comm. 6-23-5510" @ 152/135 TD 2959 7" @ 2952DD 2961 FU 160' oil 50' wtr 12 hr.S/ 3/4 bo 1/4 bwphComp. 20 bopd 5 bw