


Map No. KANSAS Sec. 25 Twp. 19 R. 2W
 Well No. 2 Prebble Farm
Wolf Creek Oil Co & Company
 NORTH Sinclair

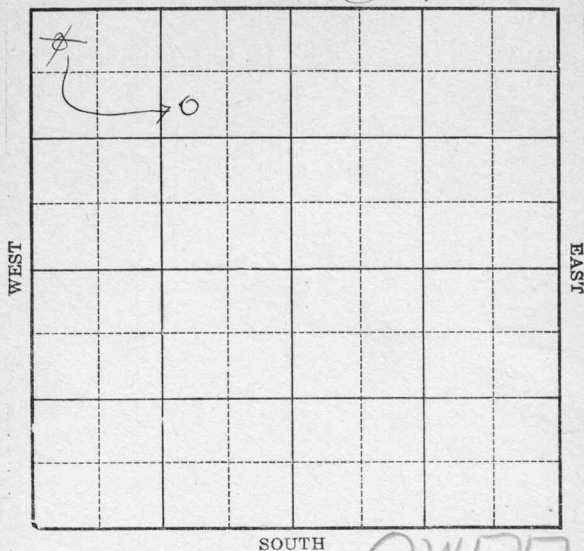

Location _____

Drilling Remarks _____

Rig Up _____

Drilling Remarks _____

RECORD

Cased _____ in. _____ ft.

Sand _____

Gas _____

Oil _____

Total Depth _____

PRODUCTION

1st 24 hrs. Nat. _____

1st 24 hrs. after shot _____

Gas _____ cu. ft.

Dry Hole _____

Abandoned _____

Map No. KANSAS Sec. 25 Twp. 19 R. 2^w

Well No. 2-Krehbill Farm
Walg Creek & Sinclair Company


990
~~330~~ Ft. from N. Line

_____ Ft. from S. Line

990 Ft. from E. Line

~~330~~ Ft. from W. Line

1932

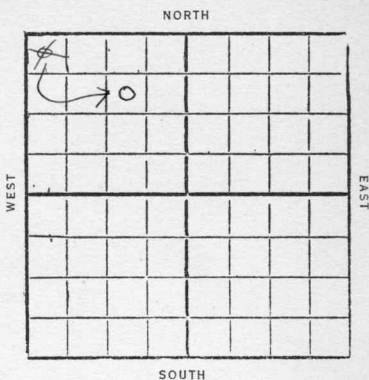

Date	REPORT
<u>2/26</u>	<u>Loc</u>
<u>3/2</u>	<u>—</u>
<u>3/9</u>	<u>—</u>
<u>3/16</u>	<u>—</u>
<u>3/22</u>	<u>—</u>
<u>3/30</u>	<u>Bldg rig</u>
<u>4/6</u>	<u>Rgn up</u>
<u>4/13</u>	<u>Cem 20"-70'</u>
<u>4/20</u>	<u>15"-10.3</u>
	<u>Drlg 500</u>
<u>4/27</u>	<u>" 1475</u>
<u>5/4</u>	<u>10"-2143</u>
	<u>Drlg 2160'</u>
<u>5/11</u>	<u>10"-2270</u>
	<u>HFW 2320-25</u>
	<u>drlg 2330'</u>
<u>5/18</u>	<u>HFW 2430-35</u>
	<u>TD 2470' UIR 10"</u>
<u>5/25</u>	<u>10"-2470</u>
	<u>Top Chat 2917</u>
	<u>Hole caving</u>
	<u>(over)</u>

Drl

6/1- dreg 2920' chat
spraying oil

6/8- TD 2995
1 M gas & show oil

6/15- TD 3000'
swab 140 bbl per day
some water

6/22- TD 3000'
Pump 210 bbl 1st 24 hr

6/29 TD 3000' No potential

7/6- Chat 2917-3000

TD 3000

Potential prod

150 bbl

Comp.

1932

OWDD

10/19- Old TD 3000'

10/26- Base line 3138
6"-3136

dreg 3365'

11/2- 5"-3380

Top Viola 3396-3414

P.B. to 3412

shot 20 qt

swab 10 bbl per hour

11/9- Pump 10 bbl per hr

11/16 P.B. to 3412' no potential

11/23- Cased 5"-3380'

Viola 3396-3414 TD.

P.B. to 3412' shot 20 qt

Potential - 353 bbl oil
Comp

43 **KANSAS** *McPherson*
 Map No. 75 Sec. 19 Twp. 24 R. 2

Well No. 2 Krehbiel
Holy Creek Oil Co. & Sinclair Company

Contractor

FIRST REPORTS

330 Ft. from N. Line

_____ Ft. from S. Line

_____ Ft. from E. Line

330 Ft. from W. Line

SECTION PLAT

0			

Location ✓

Rig up _____

Drilling and Remarks:

RECORD

Cased _____ in., _____ ft.

Sand _____

Gas _____

Oil _____

Total Depth _____

PRODUCTION

1st 24 hrs. Nat. _____

1st 24 hrs. after shot _____

Gas _____ Cu. Ft.

Dry Hole _____

Abandoned _____

Date

FEB 26 1932

19

CHAS. L. SHERWOOD

Scout

McPdereson

43 **KANSAS** Map No. _____ Sec. 25 Twp. 19 R. 2 ^WWell No. 2 Krehbiel
Waly Creek & Sinclair Company

Contractor _____

CORRECTION

990 Ft. from N. Line

_____ Ft. from S. Line

990 Ft. from E. Line

_____ Ft. from W. Line

SECTION PLAT

0			

Location _____

Rig up _____

Drilling and Remarks:

Change location

RECORD

Cased _____ in., _____ ft.

Sand _____

Gas _____

Oil _____

Total Depth _____

PRODUCTION

1st 24 hrs. Nat. _____

1st 24 hrs. after shot _____

Gas _____ Cu. Ft.

Dry Hole _____

Abandoned _____

Date

MAR 30 1932

19

CHAS. L. SHERWOOD

Scout

43 KANSAS

Map No. _____ Sec. 25 Twp. 19 R. 2

Well No. 2 Grebick

Noel Creek & Sinclair Company

Contractor _____

COMPLETED

SECTION PLAT

990 Ft. from N. Line

_____ Ft. from S. Line

990 Ft. from E. Line

_____ Ft. from W. Line

	o		

Location _____

Rig up _____

Drilling and Remarks:

Potential Prod
150 Bbls

RECORD

Cased _____ in., _____ ft.

Sand _____

Gas _____

Oil _____

Total Depth 3000

PRODUCTION

1st 24 hrs. Nat. _____

1st 24 hrs. after shot _____

Gas _____ Cu. Ft.

Dry Hole _____

Abandoned _____

Date

JUL 6 1932 CHAS. L. SHERWOOD

192

Scout

43 KANSAS Map No. Sec. 25 Twp. 19 R. 2W

Well No. 2 - Kreibel

Wolfe-Creek + Sinclair Company

Contractor

FIRST REPORTS

SECTION PLAT

	0		

990 Ft. from N. Line

Ft. from S. Line

990 Ft. from E. Line

Ft. from W. Line

Location SW NE NW

Rig up

Drilling and Remarks:

Oil, N. N. old

RECORD

Cased in., ft.

Sand

Gas

Oil

Total Depth 3000

PRODUCTION

1st 24 hrs. Nat.

1st 24 hrs. after shot

Gas Cu. Ft.

Dry Hole

Abandoned

Date

OCT 19 1932

192

Sherwood Scout

43 KANSAS

McPherson

Map No. Sec. 25 Twp. 19 R. 2

Well No. 2 Krehlke

Wray Creek-Sinclair-Prarie Company

Contractor

COMPLETED

SECTION PLAT

	o		

990 Ft. from N. Line

Ft. from S. Line

990 Ft. from E. Line

Ft. from W. Line

Location

Rig up

Drilling and Remarks:

OB to 3412
 2 hat 20 gts
 Potentius Prod
 353 bbls.

RECORD

Cased 5 in., 3380 ft.

Sand Viola 3396-3414

Gas

Oil

Total Depth 3414

PRODUCTION

1st 24 hrs. Nat.

1st 24 hrs. after shot

Gas Cu. Ft.

Dry Hole

Abandoned

Date

NOV 23 1932

192

CHAS. L. SHERWOOD

Scout