

Section 25 Township 19 Range 2-W

Well No. #2 Suffield

Company Mueller et al

NORTH Ritz Canton Pool

WEST

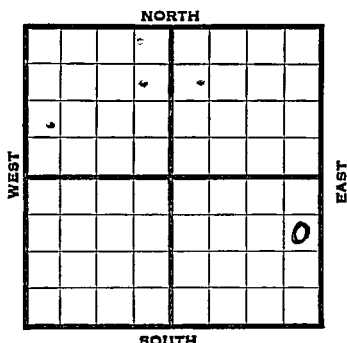
EAST

0

SOUTH

KANSAS**McPherson**Sec. 25 Twp. 19 R. 2-WWell No. #2 Suffield Farm
Mueller et al Company

(Ritz-Canton)

990 Ft. from N. Line Ft. from S. Line330 Ft. from E. Line Ft. from W. Line

1939	REPORT
2/1	15" - 100' . 12" - 785' . Drlg. 885' .
2/10	Drlg. 1735' .
2/17	10" - 1950' Drlg. 2230
2/23	" " " "
3/3	" " " "
3/10	8" - 2441' 6" - 2915' Chat. 2915' S. G. 2926'
	Increase 2930' T. D. 2930' 2936
	U. R. 6" .
3/17	T.D. 2936' (Corrected) 6" - 2936'
3/24	Chat. 2917' (Corrected) T. D. 2958' S. O.
	Est. 6 M gas. 5" - 2958' WOC.
3/31	T. D. 2967' 2000 acid. Pump 95 oil in 11 hours. 2½ M gas.
4/7	" " " " "
	OVER

1939

4/12

5" - 2958'

Chat. 2917'

T. D. 2967'

2000 acid.

Pump 105 bbls. 8 hrs.

Potential 316 bbls.

COMPLETED

Map No. 43 Sec. 25 Twp. 19 R. 2WWell No. 2 SuffieldMueller et al Company

Contractor

FIRST REPORT

~~SE NE SE~~
~~NE SE SE~~990 Ft. from N. Line Ft. from S. Line330 Ft. from E. Line Ft. from W. Line

RITZ CANTON POOL

SECTION PLAT

SE Quarter originally belonged to Lario			

Location Rig up

Drilling and Remarks:

15" - 100

12" - 785

Drlg. 885

RECORD

Cased in., ft.Sand Gas Oil Total Depth

PRODUCTION

1st 24 hrs. Nat. 1st 24 hrs. after shot Gas Cu. Ft.Dry Hole Abandoned

Date

FEB 1 - 1939 19 H. D. Hatfield Scout

McPherson

KANSAS

Map No. 43 Sec. 25 Twp. 19 R. 2WWell No. 2 SuffieldMueller et al

Company

Contractor

COMPLETED

SECTION PLAT

			0

990 SE NE SE
Ft. from N. Line

Ft. from S. Line

330 Ft. from E. Line

Ft. from W. Line

RITZ CANTON POOL

Location

Rig up

Drilling and Remarks:

*2000 Acid**P-105/8**Pot 316*

RECORD

Cased 5 in., 2958 ft.Sand Chat 2917

Gas

Oil

Total Depth 2967

PRODUCTION

1st 24 hrs. Nat.

1st 24 hrs. after shot

Gas Cu. Ft.

Dry Hole

Abandoned

Date

APR 12 1939

19

E. D. Hatfield Scout