

KANSAS

Barton

Section 25 Township 19 Range 14W

Well No. 1 Koch

Company Phillips & Hansen

Wildcat

NORTH

| | | | | | | | |
|--|--|--|--|--|--|--|---|
| | | | | | | | |
| | | | | | | | |
| | | | | | | | |
| | | | | | | | 6 |
| | | | | | | | |
| | | | | | | | |
| | | | | | | | |
| | | | | | | | |

WEST

EAST

SOUTH

8

KANSAS

Barton ✓

Sec. 25 Twp. 19 R. 1/W

Well No. 1 Koch Farm

Phillips & Hansen Company


Wildcat

_____ Ft. from N. Line

330 Ft. from S. Line

330 Ft. from E. Line

_____ Ft. from W. Line

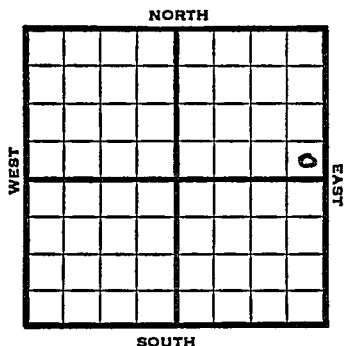

SE NE

1949 Elev 1869' REPORT

9/28 Loc.
10/5 "
10/12 "
10/19 "
10/26 "
11/1 8" @ 590'
Drlg. 2480'
11/9 Lansing 3198'
Drlg. 3476'
11/16 TD 3528'
Arb. 3479'
Aband.

ABANDONED

Map No. _____ Sec. 25 Twp. 19 R. 14W

Well No. 1 Koch

Phillips & Hansen Company

Contractor

SE NE

FIRST REPORT
SECTION PLAT

_____ Ft. from N. Line

330 Ft. from S. Line

330 Ft. from E. Line

_____ Ft. from W. Line

| | | | |
|--|--|--|--|
| | | | |
| | | | |
| | | | |
| | | | |

Barton County

Location X

Rig up

Drilling and Remarks:

RECORD

Cased _____ in., _____ ft.

Sand _____

Gas _____

Oil _____

Total Depth _____

PRODUCTION

1st 24 hrs. Nat. _____

1st 24 hrs. after shot _____

Gas _____ Cu. Ft.

Dry Hole _____

Abandoned _____

Date

SEP 28 1949

19

S. J. LEWIS

Scout

Kansas

Map No. _____ Sec. 25 Twp. 19 R. 14W

Well No. 1 Koch

Phillips & Hansen Company

ABANDONED

Contractor

SE NE

E 11728
SECTION PLAT

_____ Ft. from N. Line

330 Ft. from S. Line

330 Ft. from E. Line

_____ Ft. from W. Line

| | | | |
|--|--|--|---|
| | | | |
| | | | |
| | | | 5 |
| | | | |
| | | | |

Barton County

Location _____

Rig up _____

Drilling and Remarks:

Cor 3479

RECORD

Cased _____ in., _____ ft.

Sand _____

Gas _____

Oil _____

Total Depth *9528*

PRODUCTION

1st 24 hrs. Nat. _____

1st 24 hrs. after shot _____

Gas _____ Cu. Ft.

Dry Hole _____

Abandoned _____

Date

NOV 16 1949

19

S. J. LEWIS

Scout