
FORM 51 25M 8-50 WESTERN Barton KANSAS

Section 25 Township 19 Range 14W

Well No. #1 Koch

Company Adkins Drlg.

2

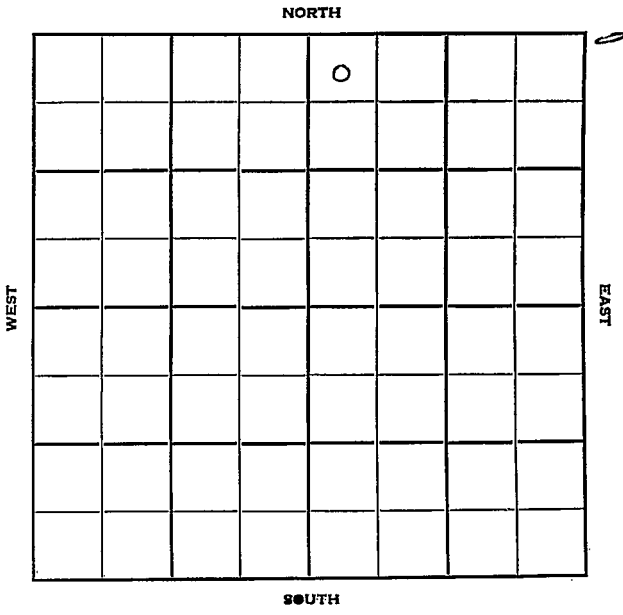

FORM 252-B
10M 8-51 TPCO. Barton

KANSAS

Sec. 25 Twp. 19 R. 14W

Well No. #1 Koch Farm

Adkins Drlg. Company

Adkins Contractor

Great Bend


330 Ft. from N. Line

Ft. from S. Line

Ft. from E. Line

330 Ft. from W. Line

NW NW NE

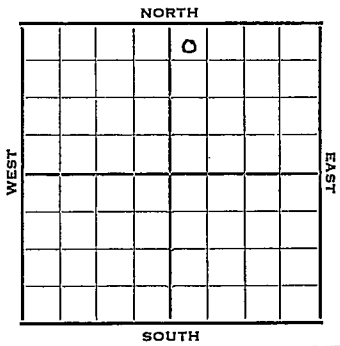

1952	Elev. 1864' REPORT
1/16	Spud 1-8-52 Anhy 767' 8" @ 780' Drlg. 2685'
1/23	Spud 1-8-52 D&A TD 3581 Anhy 767 8" @ 780 Heeb. 3090 Br lime 3185 Lans 3196 DST 3200-10 opn ½ hr. Rec. 11' vsocm DST 3255-69 opn 1 hr. Rec. 15'mud DST 3318-32 opn 1 hr. Rec. 10' mud Cong. 3429 Cherty Cong. 3440 DST 3440-63 opn 40 min Rec. 15' mud Arb. 3501 TD 3581 D&A ABANDONED

FORM 275 FOR SALE BY KANSAS BLUE PRINT CO.


County Barton State Kansas

Sec. 25 (Blk. Twp.) 19 (Sur. Rge.) 14W Map No.

Operator Adkins Drlg.

Well No. 1 Farm Koch

Elev. 1864 Location NW NW NE

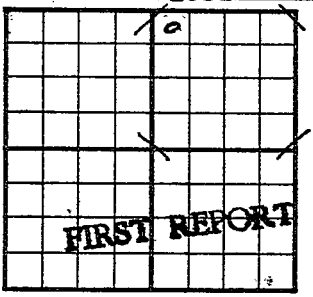

330 Ft. From N Line NE

330 Ft. From W Line Quarter

1st. Report JAN 1 6 1952

Completion

Remarks

Adkins - Contr.

Spudding Date 1-8-52

Drlg. Data Great Bend

Arbuckle 767 8" @ 780 Drlg. 2685

- J. E. TYRA

FORM 275 FOR SALE BY KANSAS BLUE PRINT CO.


County Barton State Kansas

Sec. 25 (Blk. Twp.) 19 (Sur. Rge.) 14W Map No.

Operator Adkins Drlg.

Well No. 1 Farm Koch

Elev. 1864 Location NW NW NE

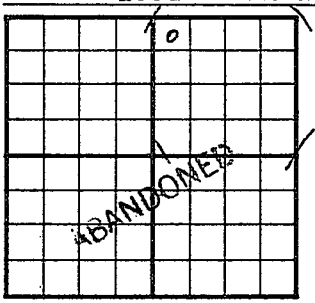

330 Ft. From N Line NE

330 Ft. From W Line Quarter

1st. Report

Completion JAN 2 3 1952

Remarks Great Bend Pool

Adkins - Contr.

Spudding Date 1-8-52

Drlg. Data D & A TD 3581

Anhy 767 8" @ 780 Heeb. 3090

Br. lime 3185 Lans. 3196 DST 3200-10

open ½ hr. Rec. 11' vsocm DST 3255-69

open 1 hr. Rec. 15' mud DST 3318-32

open 1 hr. Rec. 10' mud Cong. 3429

Cherty Cong. 3440 DST 3440-63 open 40 mi

Rec. 15' mud Arb. 3501 TD 3581

D & A

J. G. McGEHEE