


Section 25 Township 19 Range 11W

Well No. #1 Koch

Company Tom Allan

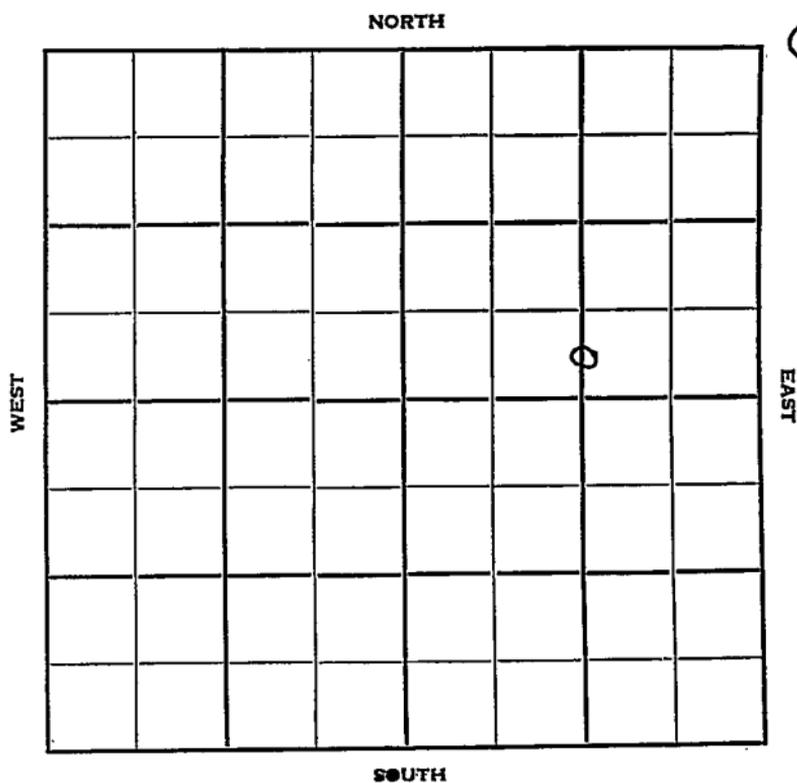

Sec. 25 Twp. 19 R. 14 W

Well No. # 1 Koch Farm

Tom Allan Company

Tom Allan Contractor

W. Great Bend Pool


Ft. from N. Line

330 Ft. from S. Line

1320 Ft. from E. Line

Ft. from W. Line

C S L S/2 NE

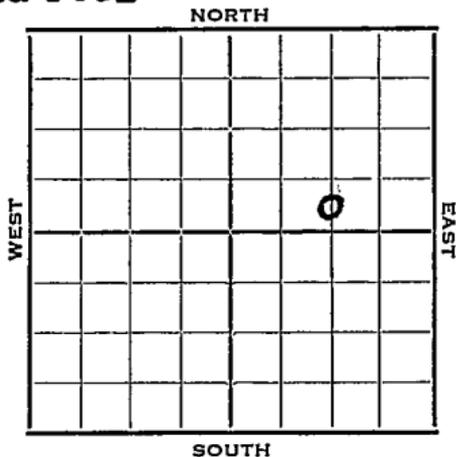

1952

Elev. 1870'

REPORT

7/23
7/30

Location
8" @ 783'
Drlg. 2490'

8/6

Heeb. 3093 Br Li 3188
Lans. 3200 RTD 3324
5" @ 3324

8/13

CO DD 3368 SSO 3363 B/ 10
galoph 300 A S/ 1 1/2 Boph 1000 A
no help POP

8/20

NR

8/27

"

9/4

Spud 7-22-52
Oil Well TD 3368
8" @ 783
Heeb. 3093 Br Li 3188
Lans. 3200
TD 3324 5" @ 3324
DD 3368 B/ 10 goph 300 A
S/ 1 1/2 boph 1000 A
Comp. 11 bopd 45 % wtr.

COMPLETED

County Barton State Kansas

Sec. 25 (Blk. Twp.) 19 (Sur. Rge.) 14W Map No.

Operator Tom Allan

Well No. 1 Farm Koch

Elev. _____ Location C S L S $\frac{1}{2}$ NE

330 Ft. From S Line NE

1320 Ft. From E Line Quarter

1st. Report JUL 23 1952

Completion _____


Remarks _____

Tom Allan - Contr.

Spudding Date 7-22-52

Drig. Data W. Great Bend Pool

County Barton State Kansas
 Sec. 25 (Blk. 19 (Sur. 14W Map No.)
 (Twp.) (Rge.)
 Operator Tom Allan
 Well No. 1 Farm Koch
 Elev. 1870 Location C S L S $\frac{1}{2}$ NE

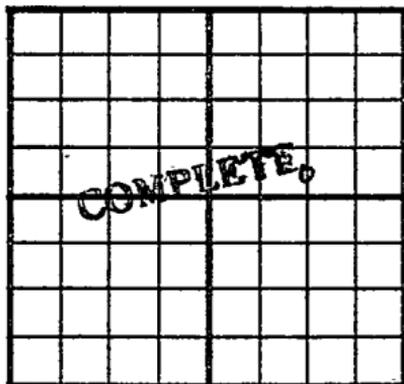

330 Ft. From S Line NE
1320 Ft. From E Line Quarter

Ist. Report

Completion SEP 4 1952

Remarks W. Gt. Bend Pool
Tom Allan - Contr.

Spudding Date 7-22-52

Drig. Data Oil well TD 3368
8" @ 783 Heeb. 3093 Br. lime 3188
Lans. 3200 TD 3324 5" @ 3324
DD 3368 B/ 10 goph 300 A S/ 1 $\frac{1}{2}$ boph
1000 A Comp. 11 bopd 45% water

J. G. McGEHEE