


Section 25 Township 19 Range 14 W

Well No. # 2 Clark

Company Tom Allen

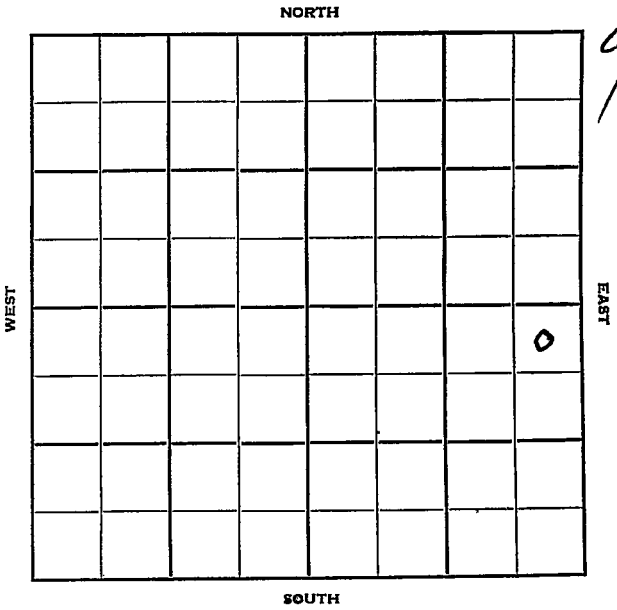

Sec. 25 Twp. 19 R. 14 W

Well No. # 2 Clark Farm

Tom Allen Company

Contractor

Great Bend Airport


NORTH

330 Ft. from N. Line

Ft. from S. Line

330 Ft. from E. Line

Ft. from W. Line

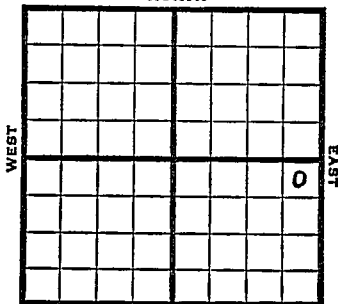

NE NE SE

1952 Elev. 1866' REPORT

- 6/4 Spud 5-27-62  
Anhy 765' 8" @ 768'  
Drlg. 2210'
- 6/11 Br li 3185' Lans. 3197'  
RTD 3315' 5" @ 3315'
- 6/18 DD 3322 TD 2000 A S/12 BOPD  
POP
- 6/25 NR
- 7/2 "
- 7/9 "
- 7/17 NR
- 7/23 "
- 7/30 "
- 8/6 "
- 8/13 "
- 8/20 Spud 5-27-52 Oil Well TD 3322  
Anhy 765 8" @ 768  
Br Lime 3185 Lans. 3197  
TD 3315 5" @ 3315 DD 3322  
2000 A S/12 boph Comp. 215 bopd

**COMPLETED**



County Barton State KansasSec. 25 (Blk. Twp.) 19 (Sur. Rge.) 14W Map No.Operator Tom AllenWell No. 2 Farm ClarkElev. 1866 Location NE NE SE

|  |  |  |  |  |  |  |  |
|--|--|--|--|--|--|--|--|
|  |  |  |  |  |  |  |  |
|  |  |  |  |  |  |  |  |
330 Ft. From N Line SE330 Ft. From E Line Quarter

Ist. Report

Completion AUG 20 1952Remarks Gt. Bend AirportSpudding Date 5-27-52Drig. Data Oil well TD 3322Anhy 765 8" @ 768 Br. lime 3185Lans. 3197 TD 3315 5" @ 3315 DD 33222000 A S/ 12 boph Comp. 215 boph