


Section 25 Township 19 Range 13W

Well No. #1 Gunn

Company Republic Natural Gas

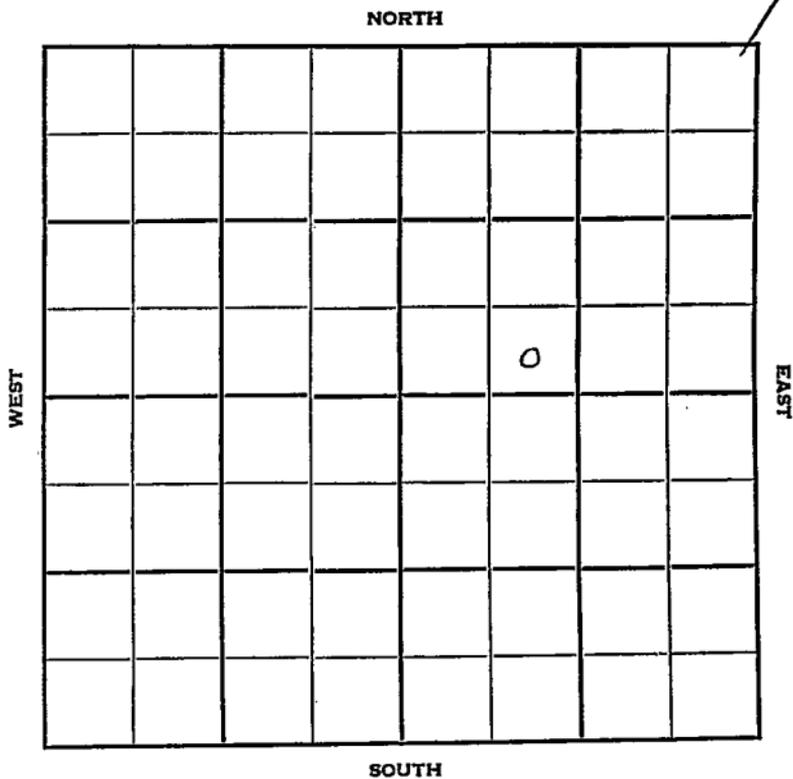

Sec. 25 Twp. 19 R. 13W

Well No. #1 Gunn Farm _____

Republic Natural Gas Company
Hartman

Contractor _____

Fort Zarah Pool


_____ Ft. from N. Line

330' Ft. from S. Line

_____ Ft. from E. Line

990' Ft. from W. Line

SE SW NE

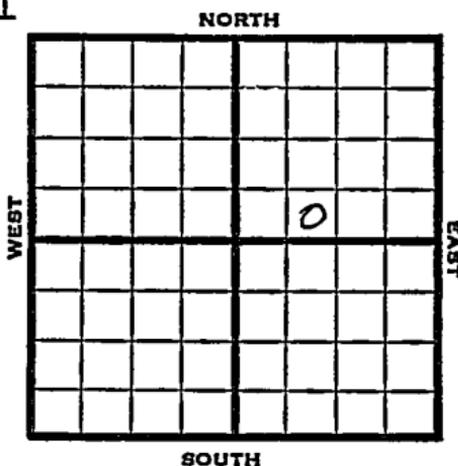

1951 Elev. 1831' REPORT

8/29

Location

9/19

Spud 9-5-51
D & A TD3494' 10" @154'
Top. 2768'
DST 2926-40 open 45 min. rec 95' mud & SW
Heeb 3014' Br. lime 3129'
Lans. 3146'
DST 3154-75 open 45 min. rec 300' SGCM
DST 3182-3215 open 35 min. rec 170' mud
Cong. 3387'
DST 3357-90 open 20 min. rec 15' mud
Arb. 3465'
DST 3470-93 opwn 1 hr. rec 150' mud & SW
TD 3494'
D & A

ABANDONED

