


Section 25 Township 19 Range 13W

Well No. #2 Gunn

Company Republic Natural

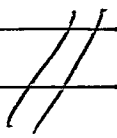

NORTH

WEST

EAST

0

SOUTH

Barton

KANSAS

SEC.	TWP.	R.
25	19	13W

WELL NO.

#2 Gunn

FARM

COMPANY

Republic Natural Gas

CONTRACTOR

Gabbert & Jones Tools

Ft. Zarah Pool

990

Ft. from N. Line


~~990~~

Ft. from S. Line

330

Ft. from E. Line

Ft. from W. Line

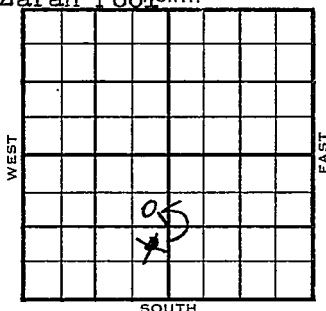SE NE SW
~~NE SE SW~~

1954

ELEVATION
1839'

REPORT

9/29

Spud 9-24-54
10" @ 170' w/175 sks
Drlg. 1970'

11/23

Spud 9-24-54
Oil Well
TD 3464'
10" @ 170'
Br. Lime 3121', Lans 3137'
DST 3140'-75' opn $\frac{1}{2}$ hr, gas in 3 min
887,000 cfg. 60' gcm 1170#
DST 3200'-35' opn 1 hr, 900' gas, 900'
s.w. 990#
DST 3272'-3302' opn 1 hr, rec 40' vsocm
O# Arb. 3386'
DST 3410'-26' opn 25 min, gas in 4 min
oil in 21 min, rec 1290' oil, 270'
wtr, 500,000 cfg. 990#
TD 3464'
7" @ 3460'
CO 48/ 3400-08 6,500,000 cfg. 24/
3412-16 S/ 5 boph 7 hr. 1000 A S/ 10
boph 6 hr. P/2 bo 1 bwph
Comp 118 bopd 70% Wtr.

COMPLETED

FABEN GILSTRAP

Kansas

Map No. _____ Sec. 25 Twp. 19 R. 13WWell No. 2 Gunn

Republic Natural _____ Company

CORRECTION

Contractor _____

SE NE SW

SECTION PLAT

990 Ft. from N. Line

_____ Ft. from S. Line

330 Ft. from E. Line

_____ Ft. from W. Line

Barton County

Location _____

Rig up _____

Drilling and Remarks:

Reported

NE SE SW

RECORD

Cased _____ in., _____ ft.

Sand _____

Gas _____

Oil _____

Total Depth _____

PRODUCTION

1st 24 hrs. Nat. _____

1st 24 hrs. after shot _____

Gas _____ Cu. Ft.

Dry Hole _____

Abandoned _____


Date

OCT 6 1954 19

FABEN GILSTRAP

Scout

County Barton State Kansas
 Sec. 25 (Blk.) 19 (Sur.) 13W Map No.
 Operator Republic Natural Gas
 Well No. 2 Farm Gunn
 Elev. 1839 Location SE NE SW

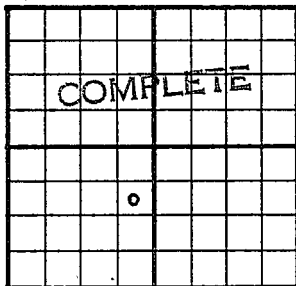

990 Ft. From N Line SW

330 Ft. From E Line Quarter

1st. Report

Completion NOV 23 1954

Remarks Ft. Zarah Pool

Gabbert-Jones - Contr.

Spudding Date 9-24-54

Drlg. Data Oil well TD 3464

10" @ 170 Br. lime 3121 Lans. 3137

DST 3140-75 open $\frac{1}{2}$ hr. gas in 3 min.

887,000 cfg 60' gcm 1170# DST 3200-35

open 1 hr. 900' gas 900' sw 990#

DST 3272-3302 open 1 hr. Rec. 40' vsocm

0# Arb. 3386 DST 3410-26 open 25 min.

gas in 4 min. oil in 21 min. Rec. 1290'

oil 270' wtr. 500,000 cfg 990#

TD 3464 7" @ 3460 CO 48/3400-08

6,500,000 cfg 24/ 3412-16 S/ 5 boph

7 hr. 1000 A -S/ 10 boph 6 hr.

P/ 2 bo 1 bwph Comp. 118 bopd 70% wtr.

FABEN GILSTRAP