


KANSAS Barton

FORM 51 IOM 12-46 PETROL

Section 26 Township 19 Range 11W

Well No. 1 Isern "B"

Company Eldorado Ref. & Adair

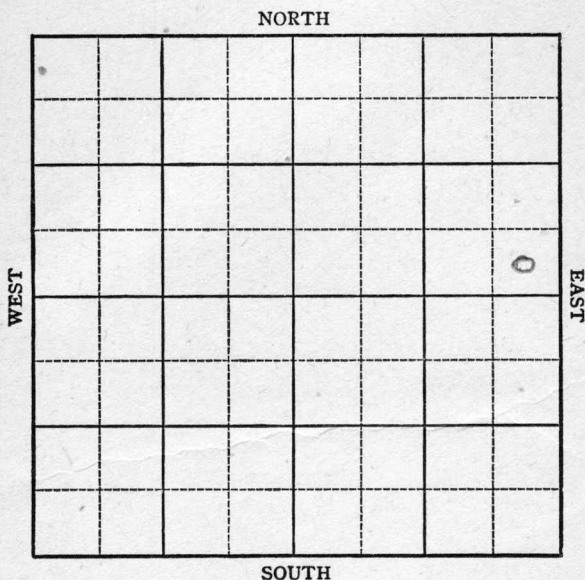

KANSAS

Barton

Sec. 26 Twp. 19 R. 11-W

Well No. 1 Isern "B" Farm


Eldorado Ref. & Adair Company

 Ft. from N. Line

330 Ft. from S. Line

330 Ft. from E. Line

 Ft. from W. Line

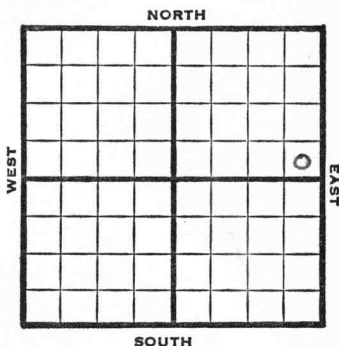

SE NE

1947 Elev. 1796' REPORT

6/4	RUR
6/10	8" @ 1978 Drilg. 2968'
6/17	Lansing 3017I Arbuckle 3287 5" @ 3288 TD 3292 1700' oil 3 hrs.
6/24	" " " "
7/1	" " " "
7/8	" "
7/16	TD 3292'
7/22	"
7/30	Arb. 3287' 5" @ 3288' Pump 450 Pot 43.0 Gr. TD 3292'

COMPLETED

Map No. _____ Sec. 26 Twp. 19 R. 11W

Well No. 1 Isern "B"

Eldorado Ref. & Adair Company

FIRST REPORT

Contractor

SE NE

SECTION PLAT

_____ Ft. from N. Line

330 _____ Ft. from S. Line

330 _____ Ft. from E. Line

_____ Ft. from W. Line

Barton County

Location _____

Rig up _____

Drilling and Remarks:

R U R

RECORD

Cased _____ in., _____ ft.

Sand _____

Gas _____

Oil _____

Total Depth _____

PRODUCTION

1st 24 hrs. Nat. _____

1st 24 hrs. after shot _____

Gas _____ Cu. Ft.

Dry Hole _____

Abandoned _____


Date

JUN 4 1947 19 S. J. LEWIS Scout

KansasMap No. 46 Sec. 26 Twp. 19 R. 11WWell No. 1 Isern "B"Eldorado Ref. & Adair Company**COMPLETE**

Contractor

SE NE

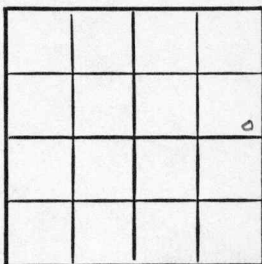E11769
SECTION PLAT Ft. from N. Line330 Ft. from S. Line330 Ft. from E. Line Ft. from W. LineBarton CountyLocation Rig up

Drilling and Remarks:

CR 828757C 8288Pink 450 BT43 2/3**RECORD**Cased in., ft.Sand Gas Oil Total Depth 8292**PRODUCTION**1st 24 hrs. Nat. 1st 24 hrs. after shot Gas Cu. Ft.Dry Hole Abandoned

Date

JUL 30 194719S. J. LEWIS

Scout