


Section 26 Township 19 Range 11W

Well No. 1 Brenn "B"

Company C. E. Ash

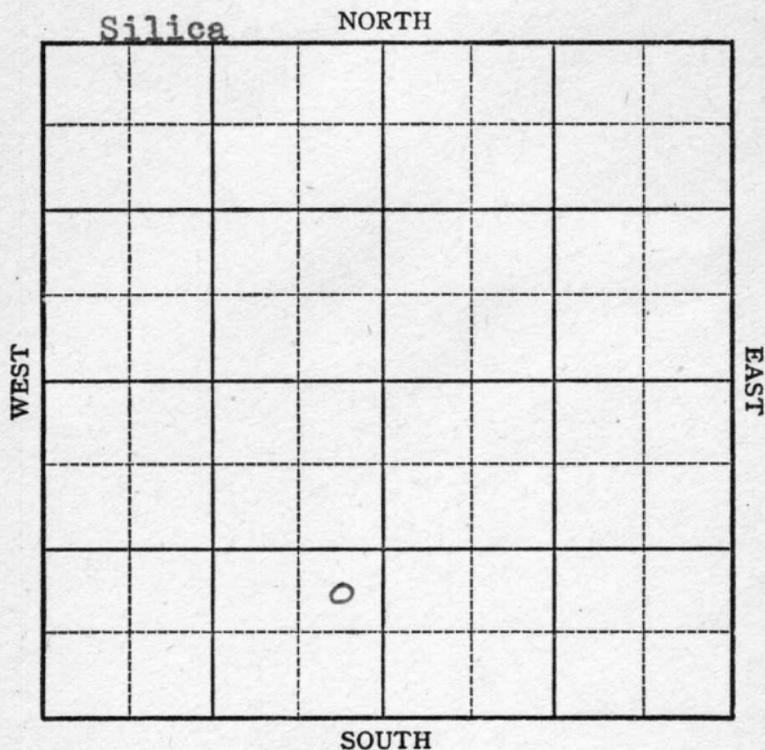

KANSAS Barton



Sec. 26 Twp. 19 R. 11W

Well No. #1 Brenn "B" Farm

C. E. Ash Company


Silica

           Ft. from N. Line

990 Ft. from S. Line

330 Ft. from E. Line

           Ft. from W. Line

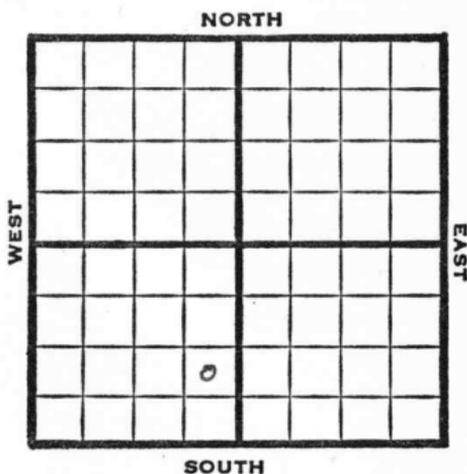

NE SE SW

1947

El 1771'

REPORT

7/23

RUR

7/29

8" @ 211'

Drig. 2430'

8/6

Lans. 3027'

Cong 3331'

3352 in Cong.

T.D. 3352'

Abandoned

ABANDONED

Kansas

Map No. \_\_\_\_\_ Sec. 26 Twp. 19 R. 11W

Well No. 1 Brenn "B"

C. E. Ash Company

FIRST REPORT Contractor

NE SE SW

**SECTION PLAT**

\_\_\_\_\_ Ft. from N. Line

990 Ft. from S. Line

330 Ft. from E. Line

\_\_\_\_\_ Ft. from W. Line

	6		

Barton County

Location \_\_\_\_\_

Rig up \_\_\_\_\_

Drilling and Remarks:

R U R

**RECORD**

Cased \_\_\_\_\_ in., \_\_\_\_\_ ft.

Sand \_\_\_\_\_

Gas \_\_\_\_\_

Oil \_\_\_\_\_

Total Depth \_\_\_\_\_

**PRODUCTION**

1st 24 hrs. Nat. \_\_\_\_\_

1st 24 hrs. after shot \_\_\_\_\_

Gas \_\_\_\_\_ Cu. Ft.

Dry Hole \_\_\_\_\_

Abandoned \_\_\_\_\_

Date

JUL 23 1947

19

S. J. LEWIS

Scout

