


Section 26 Township 19 Range 11-W

Well No. #1 Ernst

Company J. H. Hershey

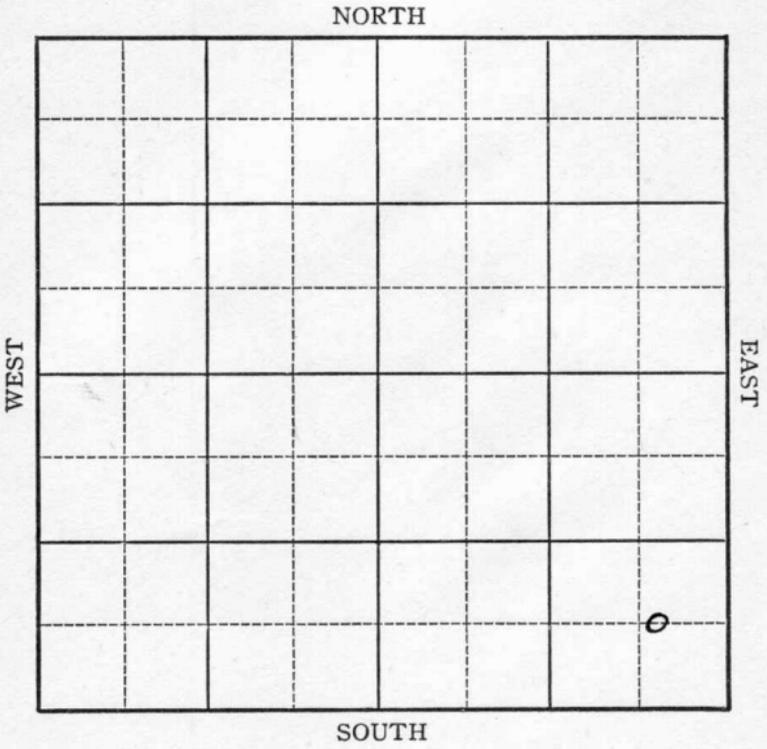

Sec. 26 Twp. 19 R. 11-W

Well No. #1 Ernst Farm

J. H. Hershey Company

Silica


_____ Ft. from N. Line

660 Ft. from S. Line

510 Ft. from E. Line

_____ Ft. from W. Line

elev. 1768

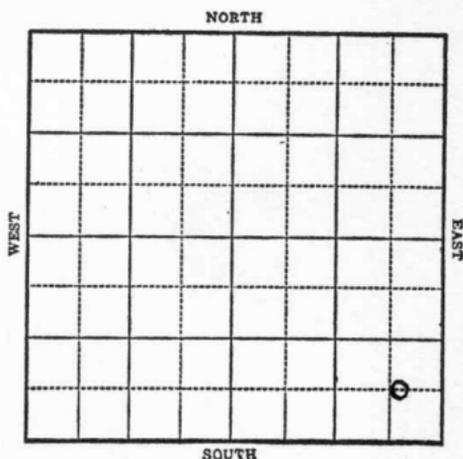

1943

R E P O R T

- 6/2 Rotary
- 6/9 8" @ 105
Drlg. 1275'
- 6/16 SD
- 6/23 2046' set whipstock at 1600'
- 6/30 Drlg. 2052'
- 7/7 Arb 3301-05 T.D.
5" @ 3302 Rust
- 7/15 T.D. 3304 swab 60 oil 7 140
water.
- 7/21 S.D.
- 7/28 "
- 8/4 "
- 8/11 "
- 8/18 Arb 3301
5" @ 3302
Pump 25 Pot.
T.D. 3305 1/2
Grav. 42

COMPLETED

KANSAS

Map No. 40 Sec. 26 Twp. 19 R. 11W

Well No. 1 Ernst

J. H. Hershey Company

FIRST REPORT

Contractor

C SE SE


SECTION PLAT

_____ Ft. from N. Line

660 Ft. from S. Line

510 Ft. from E. Line

_____ Ft. from W. Line

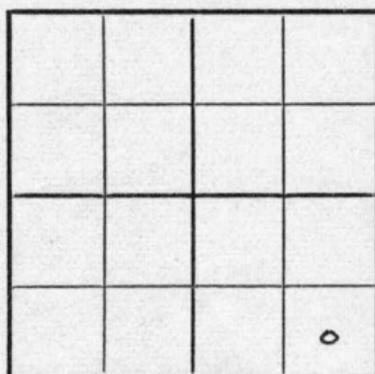

SILICA POOL

Location _____

Rig up _____

Drilling and Remarks:

Rotary

RECORD

Cased _____ in., _____ ft.

Sand _____

Gas _____

Oil _____

Total Depth _____

PRODUCTION

1st 24 hrs. Nat. _____

1st 24 hrs. after shot _____

Gas _____ Cu. Ft.

Dry Hole _____

Abandoned _____

Date

JUN 2 1943 19

S. J. LEWIS Scout

KANSAS

Map No. 46 Sec. 26 Twp. 19 R. 11W

Well No. 1 Ernst

J. H. Hershey Company

COMPLETED Contractor

SECTION PLAT

C SE SE
Ft. from N. Line

660 Ft. from S. Line

510 Ft. from E. Line

_____ Ft. from W. Line

			σ

SILICA POOL

Location _____

Rig up _____

Drilling and Remarks:

Cor of 3301

5" C3302

Pump 25 RT

42 ± ft

RECORD

Cased _____ in., _____ ft.

Sand _____

Gas _____

Oil _____

Total Depth 3305 1/2

PRODUCTION

1st 24 hrs. Nat. _____

1st 24 hrs. after shot _____

Gas _____ Cu. Ft.

Dry Hole _____

Abandoned _____

Date

AUG 1 8 1943 19

S. J. LEWIS Scout