


Section 26 Township 19 Range 12W

Well No. 1 Apel

Company Aladdin Pet

Hammer
NORTH

2

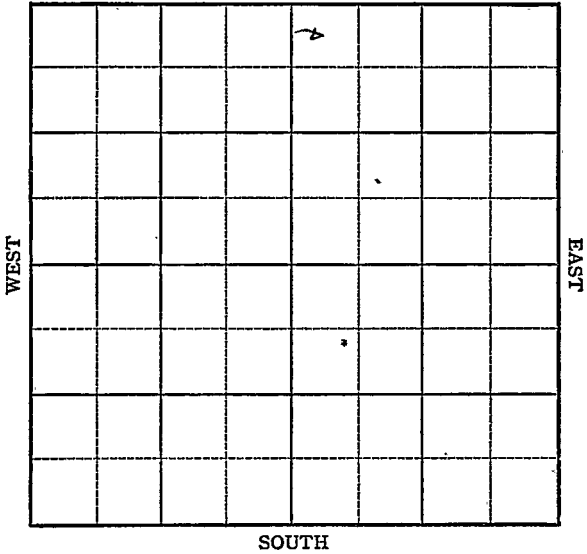

Sec. 26 Twp. 19 R. 12W ✓

Well No. #1 - Apel Farm _____

Aladdin Pet. Company _____

Hammer Pool


330' Ft. from N. Line

_____ Ft. from S. Line

_____ Ft. from E. Line

330' Ft. from W. Line

NW NE

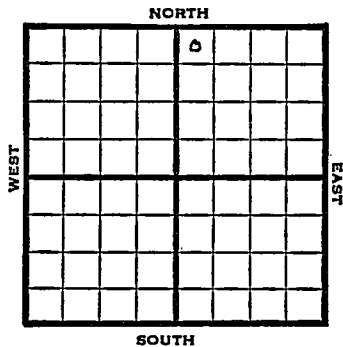

1949

Elev 1804'

REPORT

3/16

Location

3/23

"

3/30

"

4/6

"

4/12

"

4/20

"

4/27

RUR

5/4

8" @ 224'

Drlg 2450'

5/10

Arb. 3348-51'

TD 3351'

5" @ 3349'

5/18

500 acid

5/25

"

6/1

"

6/7

Pump 40 bbls oil a day

6/15

"

6/21

"

6/29

TD 3351'

Arb. 3348'

5" @ 3349'

500 acid

Pump 94 Oil / 3% W Pot

200 Gr.

Comp

COMPLETED

Kansas

Hammer Pool

Map No. _____ Sec. 26 Twp. 19 R. 12WWell No. 1 ApelAladdin Pet. Company

FIRST REPORT Contractor

NW NE

SECTION PLAT

330 Ft. from N. Line

_____ Ft. from S. Line

_____ Ft. from E. Line

330 Ft. from W. Line

		0	

Barton County

RECORD

Location X

Cased _____ in., _____ ft.

Rig up _____

Sand _____

Drilling and Remarks: _____

Gas _____

Oil _____

Total Depth _____

PRODUCTION

1st 24 hrs. Nat. _____

1st 24 hrs. after shot _____

Gas _____ Cu. Ft.

Dry Hole _____

Abandoned _____

Date

MAR 16 1949 19S. J. LEWIS Scout

