


Section 26 Township 19 Range 12W

Well No. #3 Apel

Company Aladdin Pet.

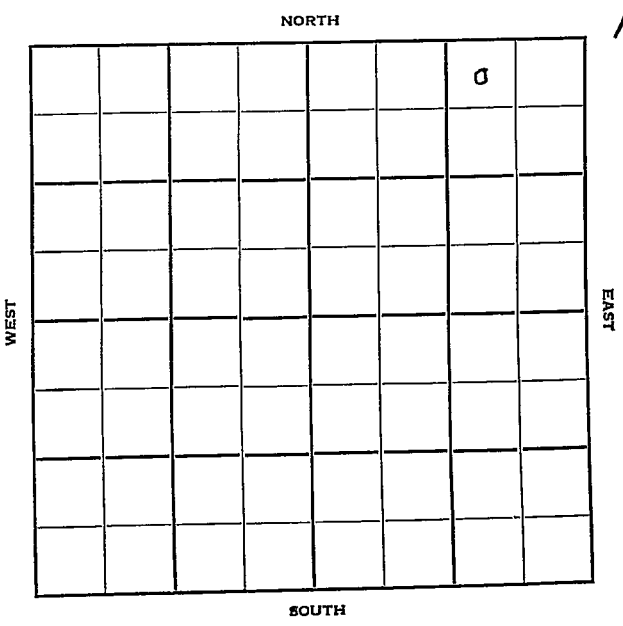

Barton KANSAS

Sec. 26 Twp. 19 R. 12W

Well No. #3 Apel Farm

Aladdin Pet.

Company

Hammer, North


330' Ft. from N. Line

\_\_\_\_\_ Ft. from S. Line

990' Ft. from E. Line

\_\_\_\_\_ Ft. from W. Line

NW NE NE

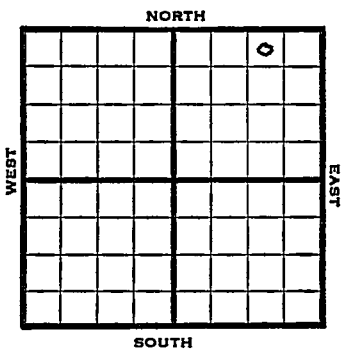

1950

Elev 1803' REPORT

1/4

Set 8-5/8" 227  
Drlg. 1200'

2/15

TD 3383'  
8 5/8" set 227'  
5" set 3376'  
Lans 3096'  
Arb. 3375'  
205 BOPD  
Comp

**COMPLETED**

Kansas

Map No. \_\_\_\_\_ Sec. 26 Twp. 19 R. 12W

Well No. 3 Apel

Aladdin Pet. \_\_\_\_\_ Company

Contractor \_\_\_\_\_

NW NE NE

## SECTION PLAT

330 Ft. from N. Line

\_\_\_\_\_ Ft. from S. Line

990 Ft. from E. Line

\_\_\_\_\_ Ft. from W. Line

|  |  |  |   |
|--|--|--|---|
|  |  |  | o |
|  |  |  |   |
|  |  |  |   |
|  |  |  |   |

FIRST REPORT

Barton County

Location \_\_\_\_\_

Rig up \_\_\_\_\_

Drilling and Remarks:

Set 8 5/8" 227

drlg. 1200

## RECORD

Cased \_\_\_\_\_ in., \_\_\_\_\_ ft.

Sand \_\_\_\_\_

Gas \_\_\_\_\_

Oil \_\_\_\_\_

Total Depth \_\_\_\_\_

## PRODUCTION

1st 24 hrs. Nat. \_\_\_\_\_

1st 24 hrs. after shot \_\_\_\_\_

Gas \_\_\_\_\_ Cu. Ft.

Dry Hole \_\_\_\_\_

Abandoned \_\_\_\_\_

Date

JAN 4 1950 19

J E TYRA Scout

Map No. \_\_\_\_\_ Sec. <sup>Kansas</sup> 26 Twp. 19 R. 12W

Well No. 3 Apel

Aladdin Pet. \_\_\_\_\_ Company

\_\_\_\_\_ Contractor

NW NE NE

El. 1803  
SECTION PLAT

330 Ft. from N. Line

\_\_\_\_\_ Ft. from S. Line

990 Ft. from E. Line

\_\_\_\_\_ Ft. from W. Line

|          |  |  |   |
|----------|--|--|---|
|          |  |  | 0 |
| COMPLETE |  |  |   |
|          |  |  |   |
|          |  |  |   |

Barton County

Location \_\_\_\_\_

Rig up \_\_\_\_\_

Drilling and Remarks:

8 5/8" @ 227  
5" @ 3376  
Lanz 3096  
Aub 3375  
205 BOPD

RECORD

Cased \_\_\_\_\_ in., \_\_\_\_\_ ft.

Sand \_\_\_\_\_

Gas \_\_\_\_\_

Oil \_\_\_\_\_

Total Depth 3383

PRODUCTION

1st 24 hrs. Nat. \_\_\_\_\_

1st 24 hrs. after shot \_\_\_\_\_

Gas \_\_\_\_\_ Cu. Ft.

Dry Hole \_\_\_\_\_

Abandoned \_\_\_\_\_

Date

FEB 15 1950

19

J. E. TYRA

Scout