

Section 26 Township 19 Range 12W

Well No. 1 Roetzel

Company M & R Oil

No Name
NORTH

3

			0				

WEST

EAST

SOUTH

Sec. 26 Twp. 19 R. 12W ✓

Well No. #1 Roetzel Farm

M & I Oil Company

No Name


330' Ft. from N. Line

_____ Ft. from S. Line

330' Ft. from E. Line

_____ Ft. from W. Line

NE NW

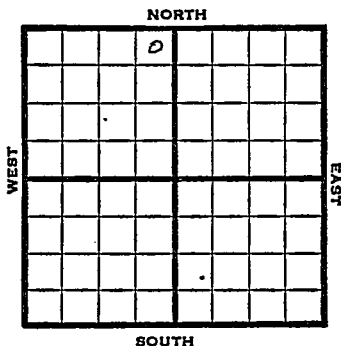

1949 Elev 1806' REPORT

2/9 Location
 2/16 RUR
 2/23 8" @ 205'
 Drlg 1016'
 3/2 Drlg 2010'
 3 /8 Lansing 3098'
 Arb. 3355'
 TD 3358
 5" @ 3356'
 3/16 TD 3376
 1000 acid W
 3/23 TD 3376'
 Arb. 3355'
 5" @ 3356'
 1000 acid
 Aband.

ABANDONED

Kansas

No Name

Map No. _____ Sec. 26 Twp. 19 R. 12 WWell No. 1 RoetzelsM & L Oil

Company

FIRST REPORT

Contractor

NE NW**SECTION PLAT**

		6	

330 Ft. from N. Line

_____ Ft. from S. Line

330 Ft. from E. Line

_____ Ft. from W. Line

BartonLocation

Rig up _____

Drilling and Remarks:

RECORD

Cased _____ in., _____ ft.

Sand _____

Gas _____

Oil _____

Total Depth _____

PRODUCTION

1st 24 hrs. Nat. _____

1st 24 hrs. after shot _____

Gas _____ Cu. Ft.

Dry Hole _____

Abandoned _____

Date

FEB 9 1949 19S. J. LEWIS

Scout

Map No. 46 Sec. 26 Twp. 19 R. 12W

Well No. 1 Roetzel

M & L Oil Company

ABANDONED Contractor

NE NW

E 1, 1906
SECTION PLAT

330 Ft. from N. Line

_____ Ft. from S. Line

330 Ft. from E. Line

_____ Ft. from W. Line

	0		

Barton County

RECORD

Location _____

Cased _____ in., _____ ft.

Rig up _____

Sand _____

Drilling and Remarks:

Gas _____

*Ord 3355
5" @ 3356
1500 acid*

Oil _____

Total Depth 3326

PRODUCTION

1st 24 hrs. Nat. _____

1st 24 hrs. after shot _____

Gas _____ Cu. Ft.

Dry Hole _____

Abandoned _____

Date

MAR 23 1949 19

S. J. LEWIS Scout