


Barton

KANSAS

Section 26 Township 19 Range 12W

Well No. #1 Schule

Company Geo. Hammum

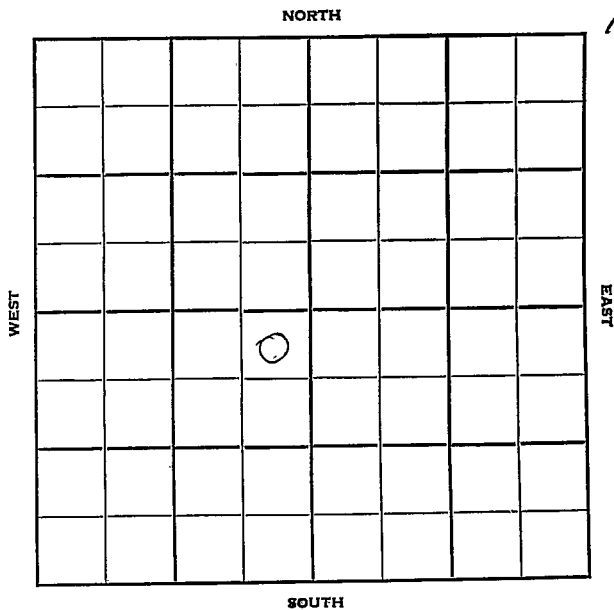

Barton

KANSAS

Sec. 26 Twp. 19 R. 12W

Well No. #1 Schule Farm

Geo Hammum Company

Geo. Hammum Contractor

Hammer


330 Ft. from N. Line

_____ Ft. from S. Line

330 Ft. from E. Line

_____ Ft. from W. Line

NE NE SW

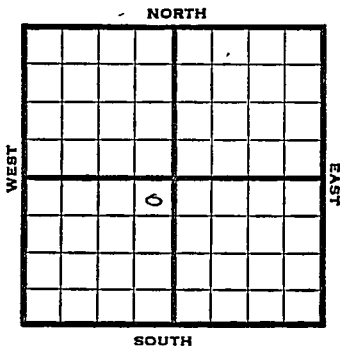

1951 Elev. 1799' REPORT

10/31 Location

11/14 D&A TD 3042' Spud 11-1-51
 Heeb. 2987' Br. Lime 3105
 Lans. 3119
 DST 3123-92 open 1 hr.
 Rec. 65' mud & wtr.
 Cong. 3373 Arb. 3395
 DST 3393-3402 open 1 hr.
 Rec. 65' mud & wtr.
 TD 3402'

ABANDONED

