

Section 26 Township 19 Range 12W

Well No. #1 Schulte

Company Adair

NORTH

9

							0

SOUTH

WEST

EAST

Barton

KANSAS

Sec. 26 Twp. 19 R. 12W

Well No. #1 Schulte Farm

Adair Company

Adair Contractor

Hammer Pool


330' Ft. from N. Line

Ft. from S. Line

330' Ft. from E. Line

Ft. from W. Line

NE NE SE

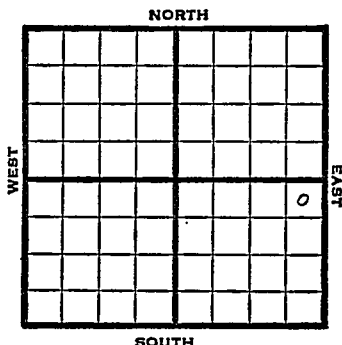

1950 Elev. 1803' REPORT

1/25 Spud 1-19-50
10" @ 230'
Anhy 627'
Drlg. 2230'
2/1 TD 3405'
10" @ 230'
Lans 3124'
Arb. 3403'
D&A
Aband.

ABANDONED

Map No. _____ Sec. 26 Twp. 19 R. 12WWell No. 1 SchulteAdair

Company

Adair

Contractor

NE NE SE

E1. 1803

SECTION FLAT

330


Ft. from N. Line

Ft. from S. Line

330

Ft. from E. Line

Ft. from W. Line

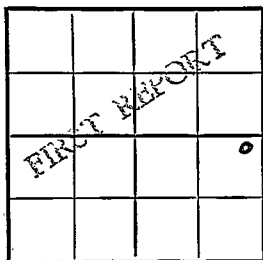Barton County

Location _____

Rig up _____

Drilling and Remarks:

Spud 1-19-50

10" @ 230

Anhy 627

drlg. 2230

RECORD

Cased _____ in., _____ ft.

Sand _____

Gas _____

Oil _____

Total Depth _____

PRODUCTION

1st 24 hrs. Nat. _____

1st 24 hrs. after shot _____

Gas _____ Cu. Ft.

Dry Hole _____

Abandoned _____

Date

JAN 25 1950

19

J. E. TYRA

Scout

Kansas

Hammer Pool

Map No. _____ Sec. 26 Twp. 19 R. 12W

Well No. 1 Schulte

Adair

Company

Contractor

NE NE SE

E1. 1803
SECTION PLAT


330 Ft. from N. Line

Ft. from S. Line

330 Ft. from E. Line

Ft. from W. Line

Barton County

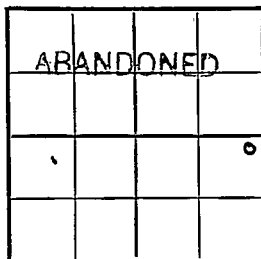

Location

Rig up

Drilling and Remarks:

10' @ 230

Lane 3124

Arb 3403

DFA.

RECORD

Cased _____ in., _____ ft.

Sand _____

Gas _____

Oil _____

Total Depth 3405

PRODUCTION

1st 24 hrs. Nat. _____

1st 24 hrs. after shot _____

Gas _____ Cu. Ft.

Dry Hole _____

Abandoned _____

Date

FEB 1 1950

19

J. E. TYRA

Scout