

KANSAS

Barton

Section 26 Township 19 Range 12W

Well No. 2 Apel

Company Aladdin Pet.

Hammer
NORTH

2

				✓	0		

WEST

EAST

SOUTH

Sec. 26 Twp. 19 R. 12W ✓

Well No. #2 Apel Farm

Aladdin Pet. Company

Hammer Pool


330' Ft. from N. Line

_____ Ft. from S. Line

_____ Ft. from E. Line

990' Ft. from W. Line

NE NW NE

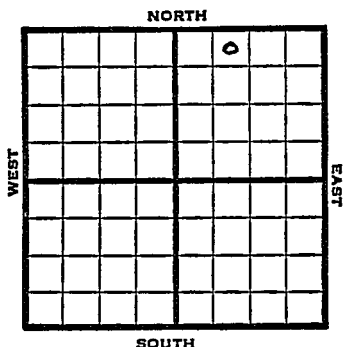

1949

Elev 1807' REPORT

6/8

8" @ 226'

Drlg. 2350'

6/15

Lansing 3191'

Arb. 3349-52'

TD 3352'

5" @ 3351'

6/21

"

6/28

TD 3367'

Swb 4½ bbls oil PH

7/6

1000 acid

7/13

TD 3367'

Arb. 3349'

5" @ 3351'

1000 acid

Pump 323 Oil Pot

40° Gr.

Comp

COMPLETED

Barton County Kansas State

Map No. _____ Sec. 26 Twp. 19 R. 12W

Well No. 2 Apel

Aladdin Pet. Company

Contractor

NE NW NE

**FIRST REPORT
SECTION PLAT**

330 Ft. from N. Line

_____ Ft. from S. Line

_____ Ft. from E. Line

990 Ft. from W. Line

Hammer Pool

Remarks:

8" @ 226 dr lg. 2350

Date **JUN 8 1949**

Scout **S. J. LEWIS**

Kansas

Map No. K46 Sec. 26 Twp. 19 R. 12WWell No. 2 Apel

Aladdin Pet.

Company

COMPLETE

Contractor

NE NW NE

E. 1807
SECTION PLAT330 Ft. from N. Line

_____ Ft. from S. Line

_____ Ft. from E. Line

990 Ft. from W. Line

Barton County

		o	

Location _____

Rig up _____

Drilling and Remarks:


RECORD

Cased _____ in., _____ ft.

Sand _____

Gas _____

Oil _____

Total Depth 3367

PRODUCTION

1st 24 hrs. Nat. _____

1st 24 hrs. after shot _____

Gas _____ Cu. Ft.

Dry Hole _____

Abandoned _____

Date

JUL 13 1949

19

S. J. LEWIS

Scout