

Section 26 Township 19 Range 12W

Well No. #4 Apel


Company Aladdin Petroleum

NORTH

7

WEST

EAST

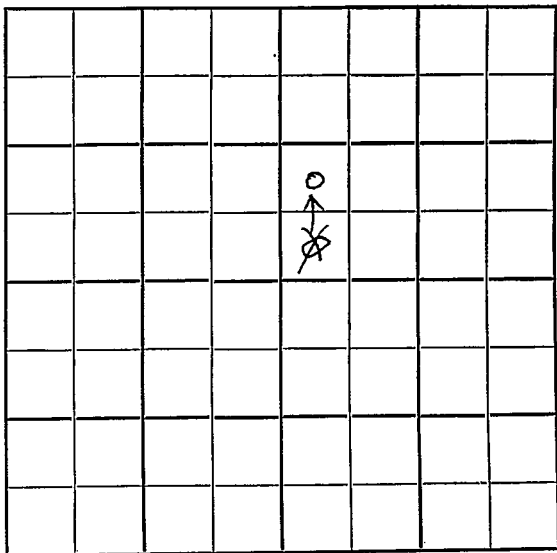

SOUTH

Barton

Sec. 26 Twp. 19 R. 12W

Well No. #4 Apel Farm

Aladdin Petroleum Company

Contractor

Hammer


           Ft. from N. Line

990  
330 Ft. from S. Line

           Ft. from E. Line

330 Ft. from W. Line

NW SW NE  
SW SW NE

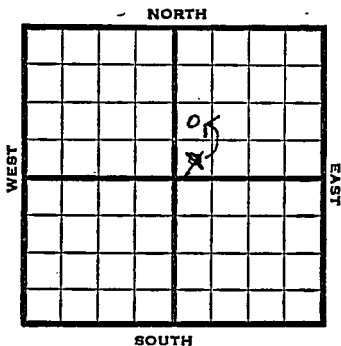

1951. Elev. 1801' REPORT

11/14 Location

1952  
2/6 MIR

2/13 8" @ 264' Anhy 618'  
Drlg. 2492'

2/20 Arb. 3370  
RTD 3374 5" @ 3371'

3/5 NR

3/12 Spud 2-6-52  
Temp Aband. TD 3374  
8" @ 264 Anhy 618-48  
Br Lime 3119 KC 3134  
Arb. 3370 5" @ 3371  
TD 3374 DD 3389 2000 A  
S/35 bwph 7 hr. 24/3278-96  
23/3241-49 2000 A  
3/4 bwph PB 3180 24/3150-60  
20/3113-21 23/3100-3108 2000 A  
Temp aband.

**ABANDONED**



Map No. \_\_\_\_\_ Sec. 26 Twp. 19 R. 12W

Well No. 4 Apel

Aladdin Pet. Company

**CORRECTION**

Contractor

NW SW NE

SECTION PLAT

\_\_\_\_\_ Ft. from N. Line

990 Ft. from S. Line

\_\_\_\_\_ Ft. from E. Line

330 Ft. from W. Line

		o	

Barton County

RECORD

Location \_\_\_\_\_

Cased \_\_\_\_\_ in., \_\_\_\_\_ ft.

Rig up \_\_\_\_\_

Sand \_\_\_\_\_

Drilling and Remarks:

Gas \_\_\_\_\_

Oil \_\_\_\_\_

Total Depth \_\_\_\_\_

Reported

PRODUCTION

SW SW NE

1st 24 hrs. Nat. \_\_\_\_\_

1st 24 hrs. after shot \_\_\_\_\_

Gas \_\_\_\_\_ Cu. Ft.

Dry Hole \_\_\_\_\_

Abandoned \_\_\_\_\_

Date

NOV 21 1951 19

J. E. TYRA Scout

Map No. \_\_\_\_\_ Sec. 26 Twp. 19 R. 12W

Well No. 4 Apel

Aladdin Pet. Company

**CONFECTION**

Contractor

NW SW NE

**SECTION PLAT**

\_\_\_\_\_ Ft. from N. Line

990 Ft. from S. Line

\_\_\_\_\_ Ft. from E. Line

330 Ft. from W. Line

		o	

Barton County

Location \_\_\_\_\_

Rig up \_\_\_\_\_

Drilling and Remarks:

Location reported

SW SW NE

Not drilled

**RECORD**

Cased \_\_\_\_\_ in., \_\_\_\_\_ ft.

Sand \_\_\_\_\_

Gas \_\_\_\_\_

Oil \_\_\_\_\_

Total Depth \_\_\_\_\_

**PRODUCTION**

1st 24 hrs. Nat. \_\_\_\_\_

1st 24 hrs. after shot \_\_\_\_\_

Gas \_\_\_\_\_ Cu. Ft.

Dry Hole \_\_\_\_\_

Abandoned \_\_\_\_\_

Date

FEB 13 1952

J. G. McGEHEE

19

Scout

