

# KANSAS


FORM 51 5M 1-42 PETROL

Rice

Section 26 Township 19 Range 10-W

Well No. #1 Flora

Company Shasta Oil Corp.

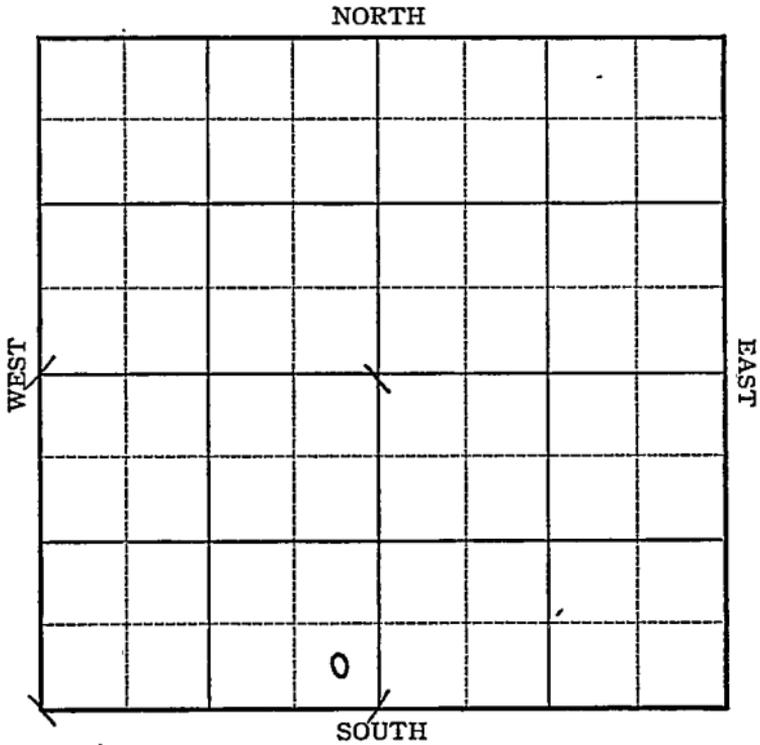


Sec. 26 Twp. 19 R. 10-W

Well No. #1 Flora Farm

Shasta Oil Corp. Company

\_\_\_\_\_ Ft. from N. Line  
330 Ft. from S. Line  
330 Ft. from E. Line  
\_\_\_\_\_ Ft. from W. Line

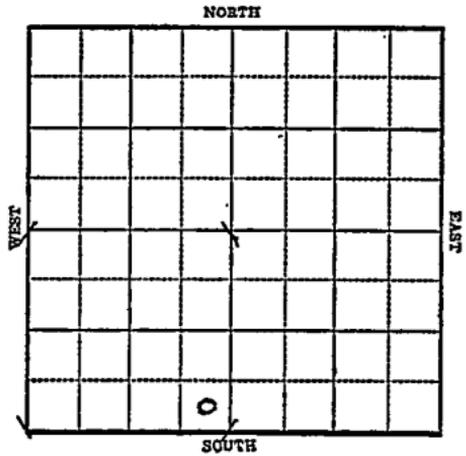

1943

R E P O R T

5/19

8" - 214'  
Topeka 2650'  
Drlg. 2780'

5/26

Lans 2991  
Simp. sd. 3304  
Arb. 3309  
T.D. 3323'

**ABANDONED**

Rice

Map **KANSAS** 46 Sec. 26 Twp. 19 R. 10W


Well No. 1 Flora

Shasta Oil Corp. Company

FIRST REPORT Contractor

SE SW

## SECTION PLAT

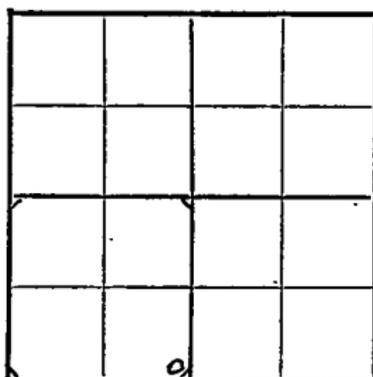

\_\_\_\_\_ Ft. from N. Line

330 \_\_\_\_\_ Ft. from S. Line

330 \_\_\_\_\_ Ft. from E. Line

\_\_\_\_\_ Ft. from W. Line

CHASE POOL

Location \_\_\_\_\_

Rig up \_\_\_\_\_

Drilling and Remarks:

8" - 214'

Topeka 2650'

Drilling 2780'

## RECORD

Cased \_\_\_\_\_ in., \_\_\_\_\_ ft.

Sand \_\_\_\_\_

Gas \_\_\_\_\_

Oil \_\_\_\_\_

Total Depth \_\_\_\_\_

## PRODUCTION

1st 24 hrs. Nat. \_\_\_\_\_

1st 24 hrs. after shot \_\_\_\_\_

Gas \_\_\_\_\_ Cu. Ft.

Dry Hole \_\_\_\_\_

Abandoned \_\_\_\_\_


Date

MAY 19 1943

19

S. J. LEWIS

Scout

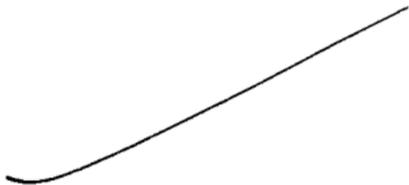

Misc Small Maps	<i>One</i>
Cards	<i>Books</i>
Tracing	<i>MS</i>
France Map	<i>✓</i>
Scarborough Map	<i>MS</i>
Moody Map	<i>MS</i>
Geological Dept.	
Moody Flat Book	

**KANSAS**

Map No. 76 Sec. 26 Twp. 19 R. 10W

Well No. 1 Flora

Shasta Oil Corp. Company

**ABANDONED** Contractor

SE SW

SECTION PLAT

\_\_\_\_\_ Ft. from N. Line

330 Ft. from S. Line

330 Ft. from E. Line

\_\_\_\_\_ Ft. from W. Line


CHASE POOL

Location \_\_\_\_\_

Rig up \_\_\_\_\_

Drilling and Remarks:

*Lease 2991*  
*Comp. No. 3304*  
*EX 3309*

RECORD

Cased \_\_\_\_\_ in., \_\_\_\_\_ ft.

Sand \_\_\_\_\_

Gas \_\_\_\_\_

Oil \_\_\_\_\_

Total Depth 332.3

PRODUCTION

1st 24 hrs. Nat. \_\_\_\_\_

1st 24 hrs. after shot \_\_\_\_\_

Gas \_\_\_\_\_ Cu. Ft.


Dry Hole \_\_\_\_\_

Abandoned \_\_\_\_\_

Date

MAY 26 1943 19

S. J. LEWIS Scout.

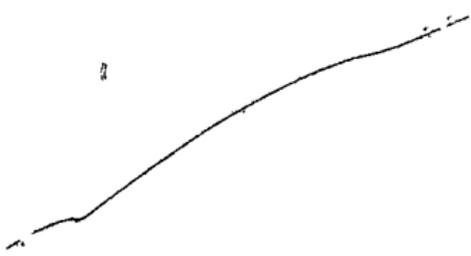

Misc Small Maps	<i>One</i>
Cards	<i>Eight</i>
Tracing	<i>Two</i>
France Map	<i>One</i>
Scarborough Map	<i>Two</i>
Moody Map	<i>Two</i>
Geological Dept.	
Moody Flat Book	