

KANSAS


Form 51-5M-7-39-Palace

Rice

Section 26 Township 19 Range 10-W

Well No. #1 Elma Flora

Company Frank Hopper et al

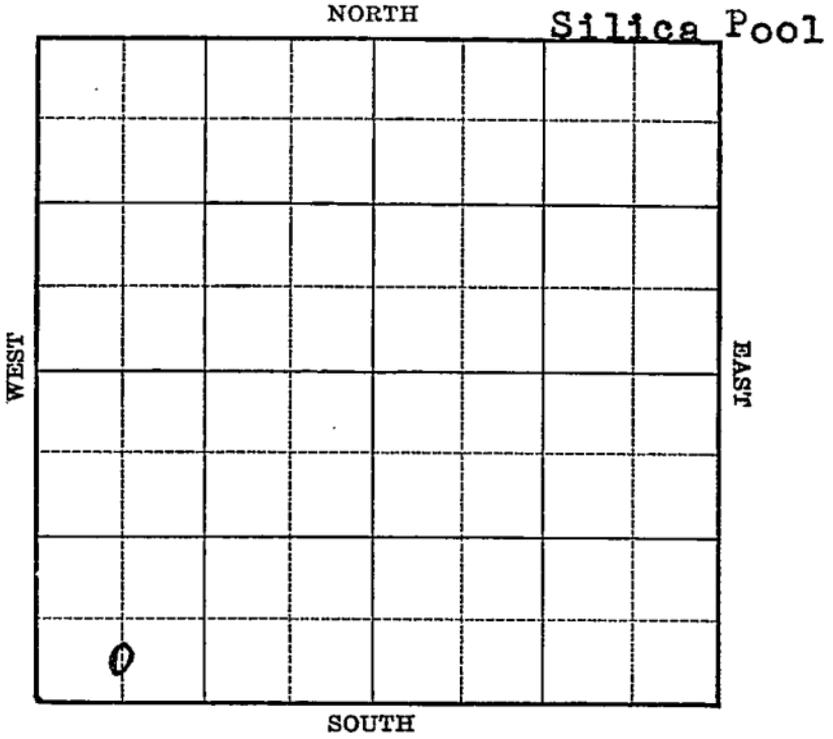

Sec. 26 Twp. 19 R. 10-W

Well No. #1 Elma Flora Farm

Frank Hopper et al Company

(Silica)


 Ft. from N. Line

330 Ft. from S. Line

 Ft. from E. Line

660 Ft. from W. Line

Elv 1749

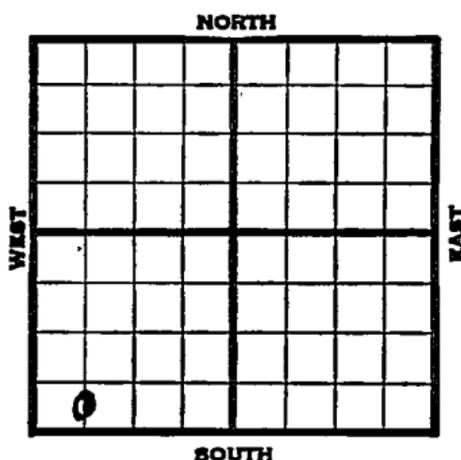

1939	REPORT
12/13	Rotary.
12/21	Rigging up.
12/28	10" - 197' Drlg. 1620'
1940	
1/4	Lansing 2979' S.O. 3003'
	Drlg. 3100'
1/11	Cong. 3269' Arb. 3306 $\frac{1}{2}$ ' 3299 $\frac{1}{2}$ '
	5" - 3307' T.D. 3309$\frac{1}{2}$ RUST.
1/18	Arb. 3299 $\frac{1}{2}$ ' (Corrected)
	5" - 3300' RUST.
1/25	T.D. 3307 $\frac{1}{2}$ ' 700' oil 20 hours.
2/1	Shut down.
2/8	" "
2/15	200 acid. Pump water.
	Recement pipe.
2/23	" " "
2/29	" " "
3/8	" " "
3/14	" " "
3/21	Shut down.
3/28	" "
4/4	" "

OVER

1940
 4/12 T.D. 3307 $\frac{1}{2}$ '
 Shut down.
 4/18 " "
 4/25 T.D. 3311' 20' of 4" liner
 perforated.
 5/2 Pump 5 bbls. oil per day.
 1000 acid. No help.
 Drlg. deeper.
 5/9 T.D. 3330' 350' water.
 5/16 P. B.
 5/23 P.B. to 3064'
 26 shots 3057-61' 500' water 12
 hours. S.S.O.
 5/29 12 shots 3039-42' , 5000 acid.
 Pump 2 bbls. fluid per hour for
 3 days.
 6/6 Drlg. 3300'
 6/13 " "
 6/20 " "
 6/27 T.D. 3330' P.B. to 3312'
 Shot 36 shots 3305 $\frac{1}{2}$ -11 $\frac{1}{2}$ '
 3 bbls. oil & S.W.

 7/2 Arb. 3299 $\frac{1}{2}$ '
 T.D. 3330'
 Water.

ABANDONED

Map No. 46 Sec. 26 Twp. 19 R. 10WWell No. 1 Elma FloraFrank Hopper et al

Company

Contractor

FIRST REPORT

C S $\frac{1}{2}$ SW SW Ft. from N. Line330 Ft. from S. Line Ft. from E. Line660 Ft. from W. Line

SECTION PLAT

SILICA POOL

Location Rig up Drilling and Remarks: Rotary

RECORD

Cased in., ft.Sand Gas Oil Total Depth

PRODUCTION

1st 24 hrs. Nat. 1st 24 hrs. after shot Gas Cu. Ft.Dry Hole Abandoned

Date

DEC 1 1939 19

S. J. LEWIS

Scout

Misc. Small Maps	<i>PAAS</i>
Cards	<i>PAAS</i>
Tracing	<i>PAAS</i>
France Map	<i>PAAS</i>
Scarborough Map	<i>PAAS</i>
Moody Map	<i>PAAS</i>
Geological Dept.	
Moody Plat Book	

Map No. 46 Sec. 26 Twp. 19 R. 10WWell No. 1 Elma FloraFrank Hopper etal Company

Contractor

ABANDONEDC S $\frac{1}{2}$ SW SW

_____ Ft. from N. Line

330 Ft. from S. Line

_____ Ft. from E. Line

660 Ft. from W. Line

SILICA POOL

SECTION PLAT

Location _____

Rig up _____

Drilling and Remarks: *Ar 3299 1/2**Water.***RECORD**

Cased _____ in., _____ ft.

Sand _____

Gas _____

Oil _____

Total Depth 3330**PRODUCTION**

1st 24 hrs. Nat. _____

1st 24 hrs. after shot _____

Gas _____ Cu. Ft.

Dry Hole _____

Abandoned _____

Date

JUL 2 1940S. J. LEWIS Scout

Misc Small Maps	<i>RAY</i>
Cards	<i>RAY</i>
Tracing	<i>RAY</i>
France Map	<i>RAY</i>
Scarborough Map	<i>RAY</i>
Moody Map	<i>RAY</i>
Geological Dept.	
Moody Plat Book	