


Section 26 Township 19 Range 10W

Well No. #1 Roelfs

Company Woodriver Oil & Ref.
Silica Pool

NORTH

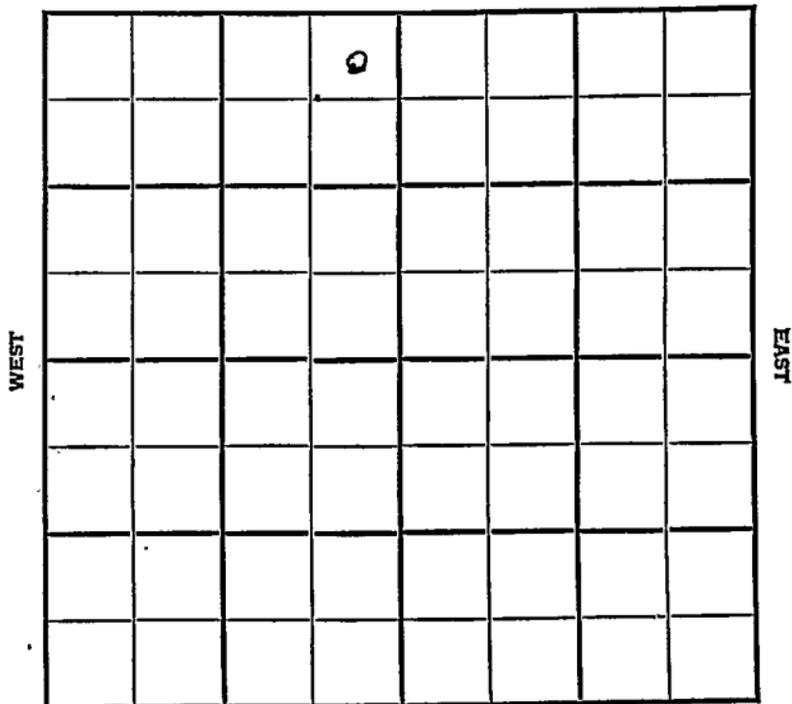

SOUTH

Sec. 26 Twp. 19 R. 10W

Well No. #1 Roelfs Farm

Woodriver Oil & Ref. Company

Silica


330 Ft. from N. Line

Ft. from S. Line

330 Ft. from E. Line

Ft. from W. Line

NE NW

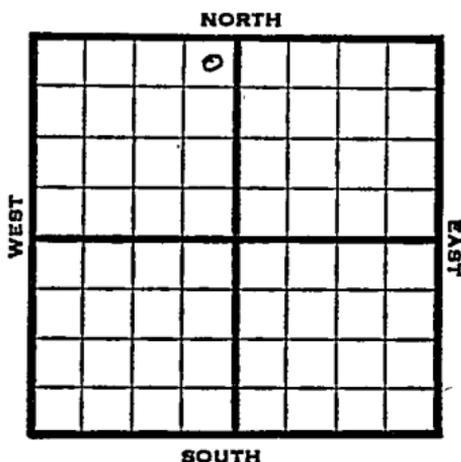

1948

Elev. 1742' REPORT

4/14

RUR

4/21

8" @ 218'
Lansing 2932'
Drlg. 3140'

4/28

Arbuckle 3282'
5" @ 3283'
TD 3288'
300 acid
Swb. 13 bb̄s. oil in 5 hrs.

5/5

"

5/12

"

5/19

"

5/26

Arbuckle 3282'
5" @ 3283'
Acid 3000
Pump 100 oil Pot.
Gr. 42.4°
TD 3288'

COMPLETED

Map No. _____ Sec. 26 Twp. 19 R. 10WWell No. 1 Roelfs

Woodriver Oil & Ref. _____ Company

FIRST REPORT _____ Contractor

NE NW


SECTION PLAT

330 Ft. from N. Line

_____ Ft. from S. Line

330 Ft. from E. Line

_____ Ft. from W. Line

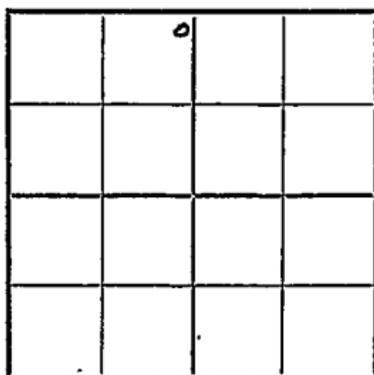

Rice County

Location _____

Rig up _____

Drilling and Remarks:

R U R

RECORD

Cased _____ in., _____ ft.

Sand _____

Gas _____

Oil _____

Total Depth _____

PRODUCTION

1st 24 hrs. Nat. _____

1st 24 hrs. after shot _____

Gas _____ Cu. Ft.

Dry Hole _____

Abandoned _____

Date

APR 14 1948

19

S. J. LEWIS

Scout

