

DX 78-1

Rice KANSAS

Section 26 Township 19 Range 9W

Well No. 1 Seeley

Company J. J. Darrah

NORTH

		0					

WEST

EAST

SOUTH

Rice KANSAS

SEC.	TWP.	R.
26	19	9W

WELL NO. **1 Seeley** FARM

COMPANY **J. J. Darrah**

CONTRACTOR


Chase-Silica Pool

330 Ft. from N. Line

Ft. from S. Line

990 Ft. from E. Line

Ft. from W. Line

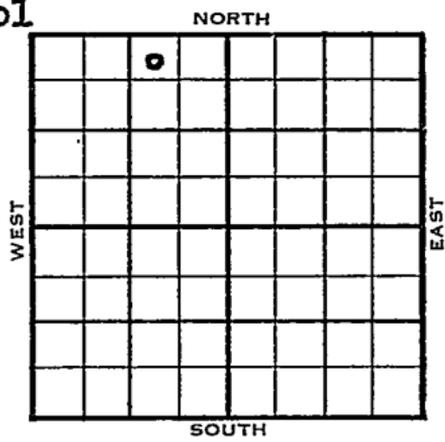

NW NE NW

1955	ELEVATION	REPORT
	1719'	

2/2 Location

3/16 Spud 2-14-55 Oil Well TD 3244
 8 5/8" @ 184 Heeb 2744, Br Lime
 2871, KC 2904, Simp 3222,
 DST 3216-35, open 1 hr Rec 15'
 mud 810#, Arb 3236,
 DST 3235-44 open 1 hr Rec 2005'
 free oil 30' 0 & GCM 1000#
 TD 3244 5" @ 3237 GO to 3244
 FU 2000' oil 1 hr S/17 BOPH 6
 hrs
 Comp. 178 BOPD

COMPLETED

County **Rice** State **Kansas**

Sec. **26** (Blk. Twp.) **19** (Sur. Rge.) **9W** Map No.

Operator **J. J. Darrah**

Well No. **1** Farm **Seeley**

Elev. **1719** Location **NW NE NW**

		o					

330 Ft. From **N** Line **NW**

990 Ft. From **E** Line Quarter

Ist. Report **FEB 2 1955**

Completion

Remarks

Spudding Date

Drlg. Data **Chase-Silica Pool**

Location

FABEN GILSTRAP

